
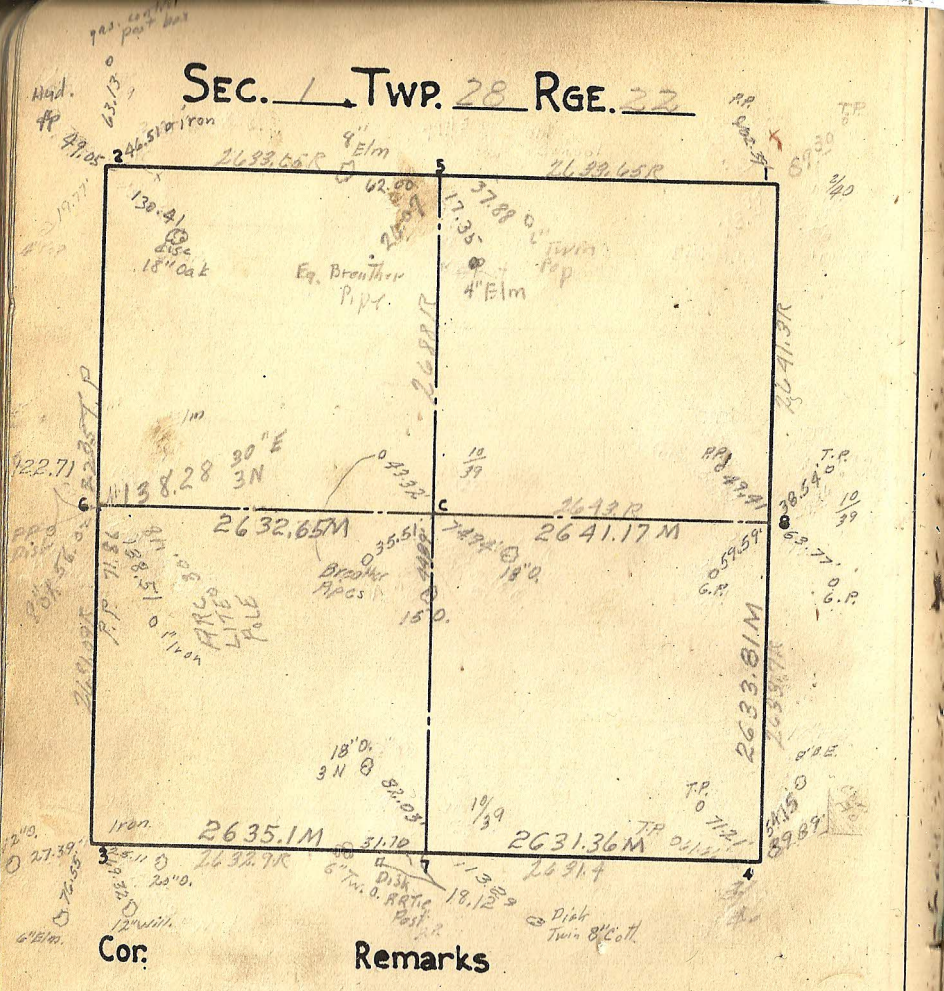

Cor.	Remarks
3	Down 3'

1

2 Washed out. Mont. Laying at Willow Tr. Ties ok. 15.8. 12/39

3

4 ok 1/4+

5 10/65 on 36

6 ok 1/4+

7

8 ok 1/4+ 11/50

C ok 1/4+ 11/50