
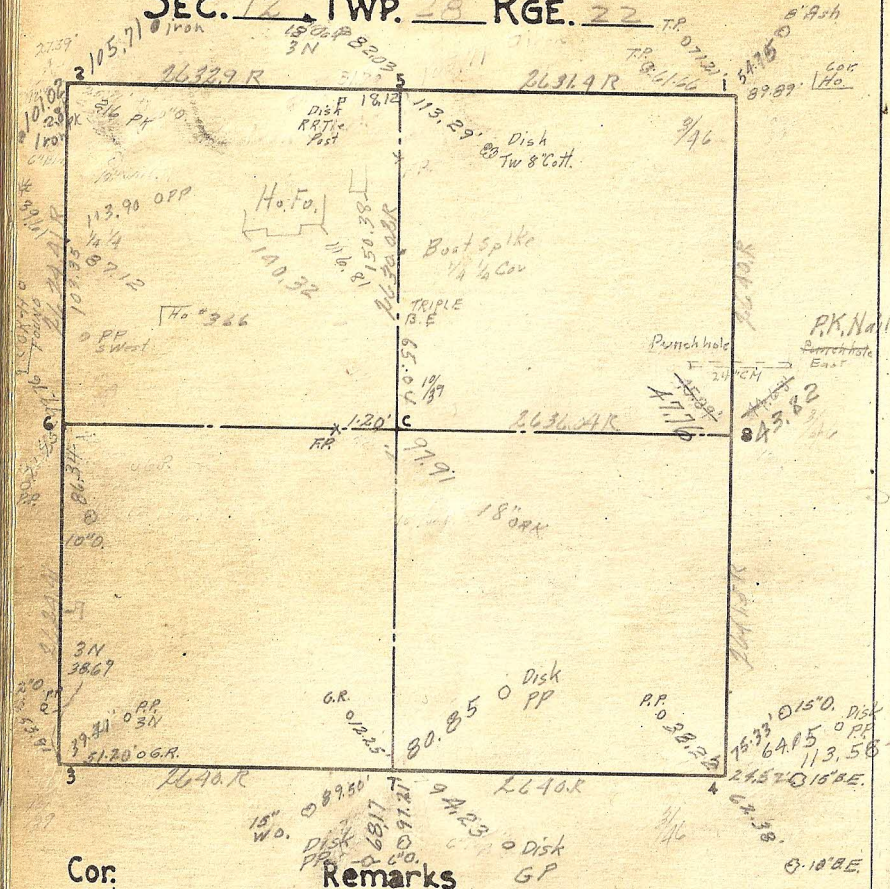

Cor.	Remarks

1318.02
2636.04

1 OK 2/44 11/50

2 Washed out Mont boring at Willow Tr Tie 10/32 K-A
Ties are OK Iron pipe Tied out 3/23/61 R76

Granite 3 OK 2/44 3/67

Granite 4 OK 2/44 11/50 2/67 Washington County C.I. Mont L.T S&E

5

6 OK 2/44 11/50

7 OK 2/44 11/50

C.I. 8 REPLACED 10/50 & 5/67

C

9

7168

6" oak