SEC. 13 TWP. 28 RGE. 22

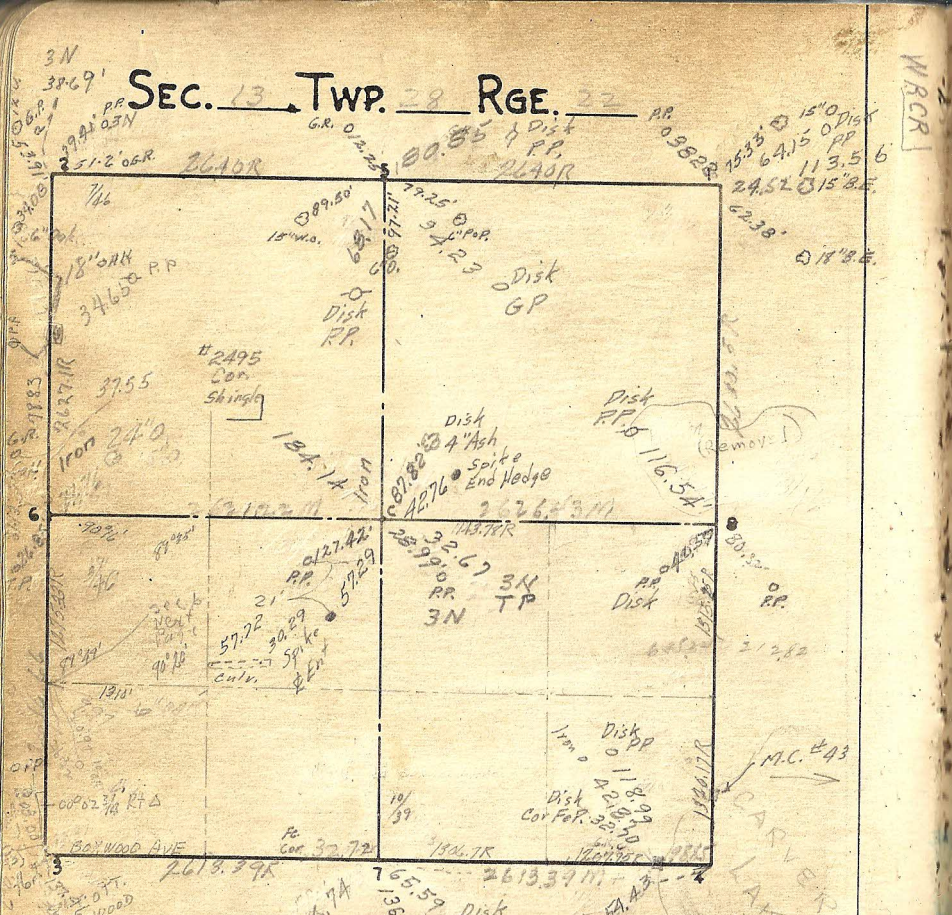

WRCR

C. I. over

Washington Co Mont.
C.I. Mon. S 4 E 1.1'

Granite 1 11/50 2/67

Granite 2 11/50 3/67

3 Reset RR Spike 3/14/61 RFG

Granite 4 M.C. West
Found Men Tipped - Straightened & Tied 4/67 Needs Check

5 6"oak 11/50

6 Twin 6"Oak 15.63 S 4 E 1.3 11/50

Granite 7 4/67 Spike 3.86

Spike 4.81

Granite 8 OK 1/4 11/50 2/67

Iron C 3/67 Ctr 94.00 100.18 69.35 28.82 No Passage Rest

Granite M.C. #43 OK 3/67
6"O. 23.65 22.58 6"Ash 3" spike
Cor Tree