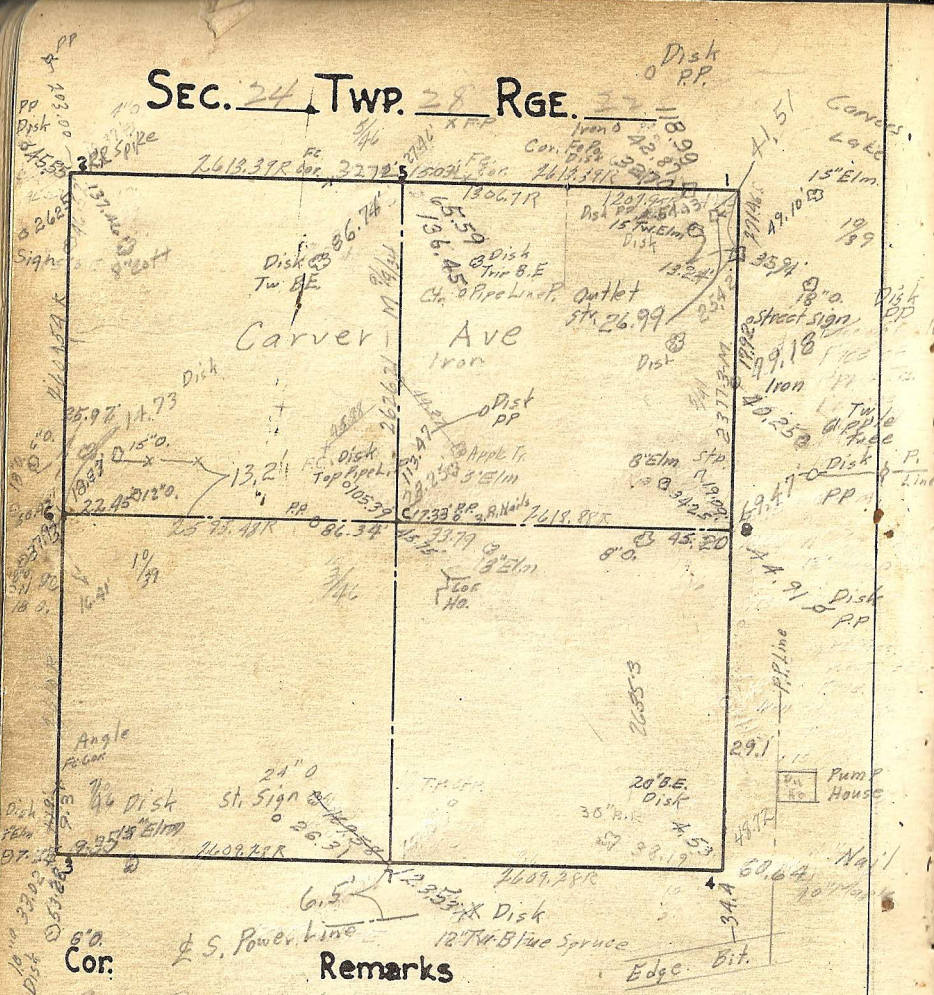

Cor.	Remarks
1	Re Est. 10-28-32
2	Mt. Eg. Cor. 400' E of Pole

MC West

Granite 1 ~~T~~ Found Mon Tipped - Straightened & Tied 4/67
Needs Checking

R.R. Spike 2 Reset & tied 3/67 RR Spike 3/67

Granite 3 3/67. 350' East of Road

Granite 4 Down 0.5' 3/67

Granite 5 3/67 Spike 3.86 4/67
Spiked

6

Iron over Mont 7 Down 1' 1/50 1/50 3/67

Granite 8 Down 1' 3/67

Bolt over C Drill Hole in Conc Mon Down 0.4' 3/67

Granite M.C. E Side Straightened & Tied 6/67