SEC. 1 TWP. 30 RGE. 22

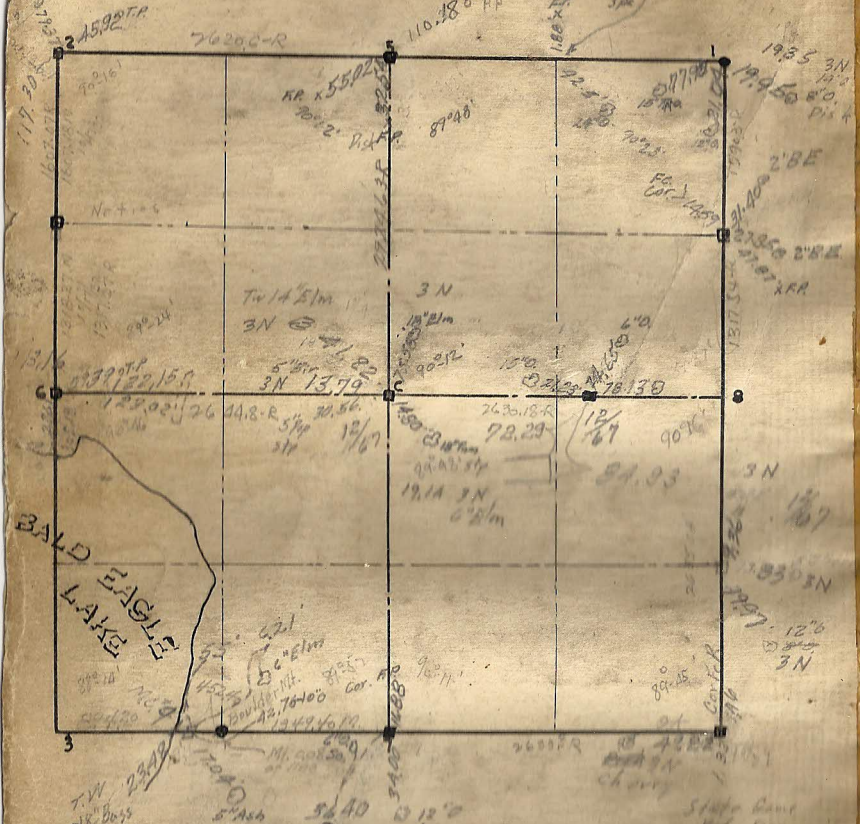

Cor.	Remarks
C.	Re est 3/14/33 by intersection Mont. Set. 1905
6	Replaced Mont with Iron - 2-40 - K.A.
M.C. #9	Placed Iron 55' East M.C. - 2-9-40 -

1 Iron Mont set by State Tied 1931
Cast Iron 4/64

Granite 4/65 2 Two Gov. trees found by Fitz. Jan 1901
Mont set Mar. 1901

3 Come in Bald Eagle Lake.

Mont Str. then Tied 11/54 4 Found one Gov. Stump nothing to tie to
Oct. 5-1897 Set mont. Nov. 15-1901

4/64 Sandstone 5 Ran Staight line E and W. and Pro.
Jan 1903 Set. Mont. Dec. 22 - 1903

4/65 Cast Iron Mont 6 Est. by Fitz Jan. 1901. Set Mt. 11-14-1901

4/64 7 Found one Gov. Tree standing and stake
set by Fitz Tied 1897 Set. Mont. 11-1901

8 Come in Swamp. Found old Stake
No Gov. witness trees. Oct. 1897

Granite 12/67 C Fixed by Intersection 1-1903 Set Mt. 12-03

M.C. #8 Ran straight line to Sec. cor. between 1-2-12-13 Pro. and fixed M.C. 1-24-1902

M.C. #9 Ran line W. from 1/4 Cor between 1-12 using Shady Side Add. Stakes used Gov. distance. Set Mt. 55' E. of M.C. Feb. 1902