SEC. 2 TWP. ___ RGE. ___

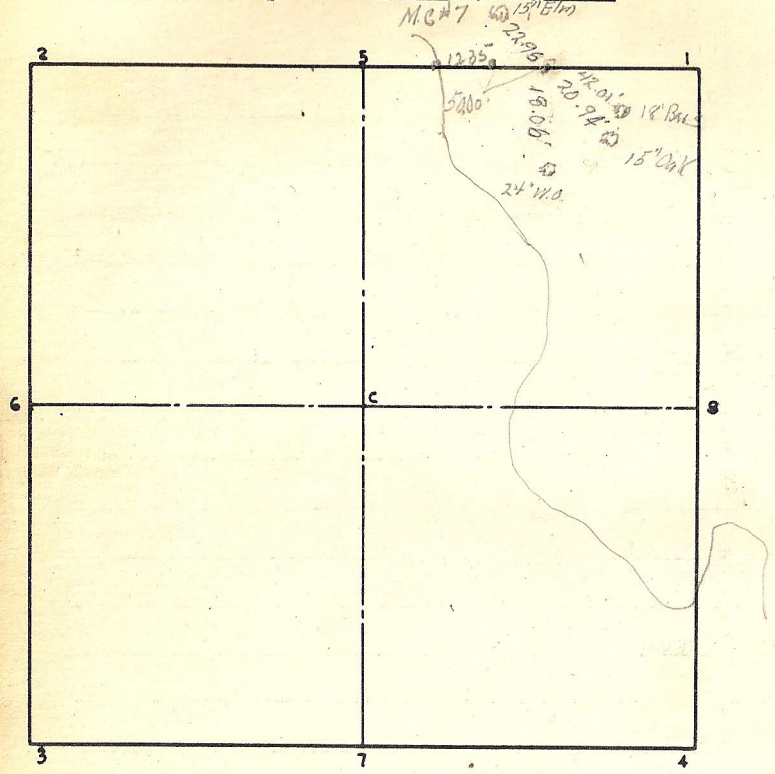


| Cor. | Remarks |
|---|---|
| MC#7 | Rest. & Moved 50.0' East of 1/64 |
| | Set Nail |

1
2
3
4
5
6
7
8
C