SEC. 4 TWP. 30 RGE. 22

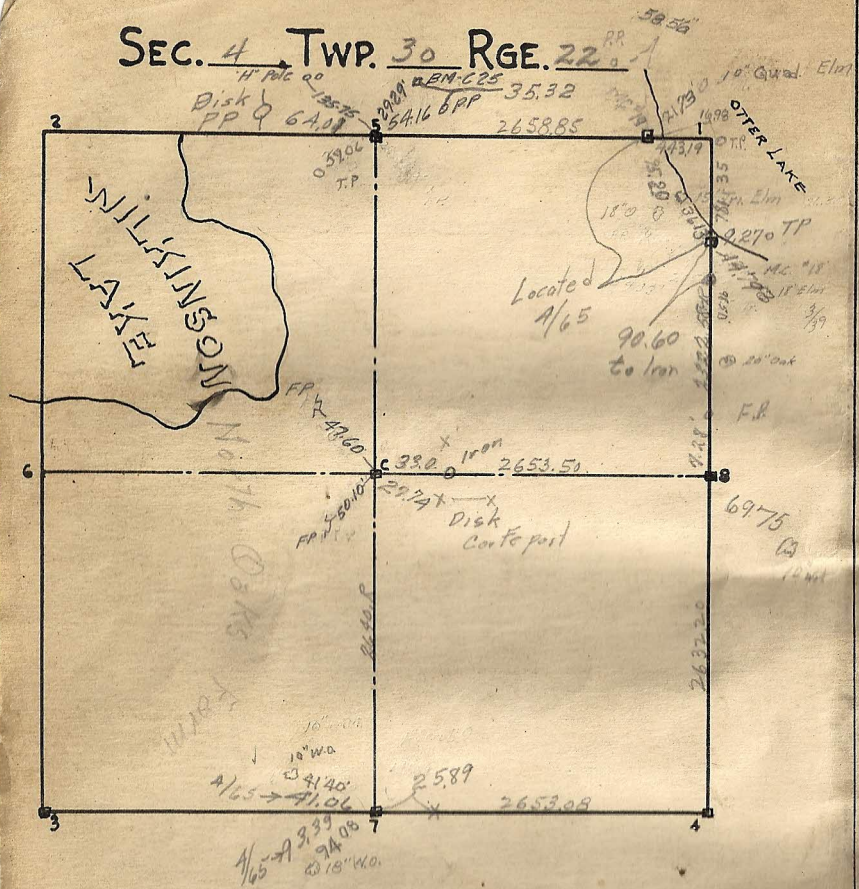

Cor.	Remarks

(3)

1

2 In Lake

3 MC #18 OK 1/54 MC #19 OK 1/54

90°17' 4 Found old stake at Sec. cor W.Ts. gone. Set mont Dec. 1902.

SE=88°49½' SW=90°10' Granite 4/65 5 Found old Iron set by State, no Gov. W.Ts 11/54 11/66 No Ties 1902

6

NE=89°47' Iron Pipe 4-65 7 Found old stake at cor Gov. W.Ts. gone Retied Jan 1910.

OK 11/54 8 Found old stake at old Fcor. Gov. W.Ts gone. Set mont Dec 1902

SE=90°02½' NE=89°56' Granite 4/65 C Ran line N and S. est cor 2640.0 ft north of 50. ¼ cor. Tied Jan. 1910.

11/54 OK MC #18 Found Two Gov W.Ts Set mont Dec. 1902.

11/54 OK MC #19 Ran meander notes from M.C. #18 and found old stake. Set Mont Dec. 1902