


SEC. 5 TWP. RGE.

6193 2 65.20 3N
PP 3N
Disk 124.02
5 89.27' 3N
D.F.P. 45.25
30.85

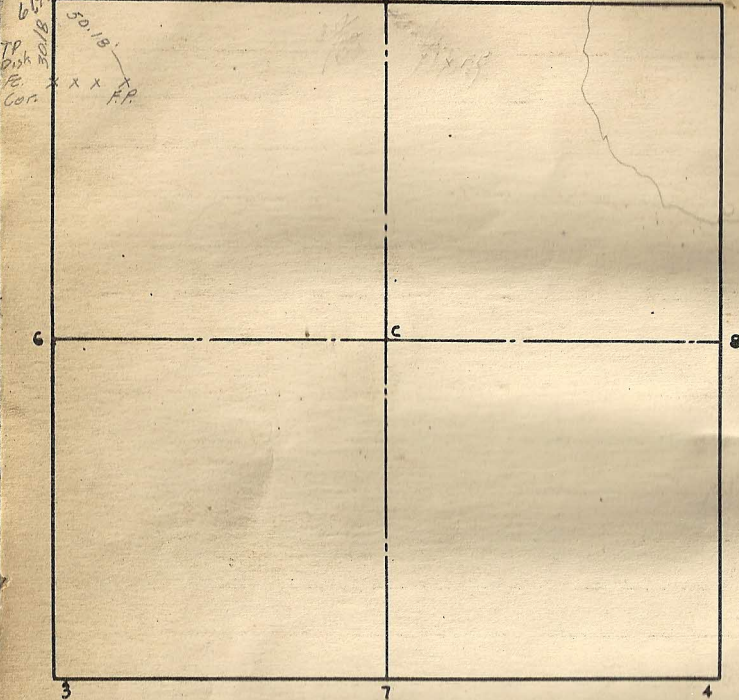

Cor: _____

Remarks _____

4/65 Granite 2 Found stake placed Mont. 6-5-40 1/5A

3 _____

4 _____

4/65 Rock 5 Found Iron 3' below rd and placed Mont over Iron 6-6-40 K.F. 1/5A

6 _____

7 _____

8 _____

C _____
