SEC. 6 TWP. RGE.

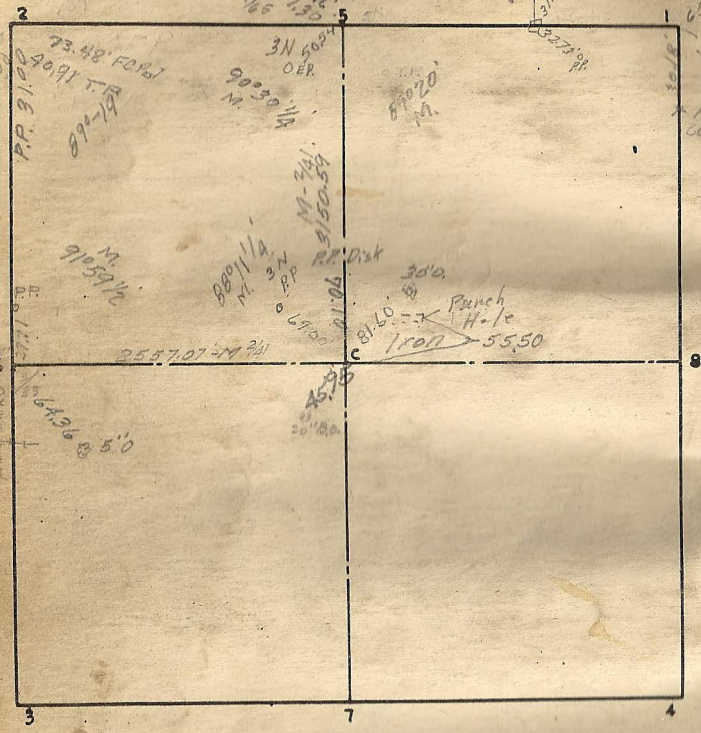

Cor.	Remarks
2	Iron Plate. Located 3-1-34
5	Placed Iron 6-3-41

Granite 1 Found Stake Placed Mont. 6-5-40 4/65

4/65 2 Found Iron mont. set by State May 18,

3

4

4/65 5 Placed Stone Mont 14x7 Pipe OK 1"50 17/54

Granite Believe Tipped 4-65 6 OK 1"39 4/65

7

8

Iron C OK 1"by 4/65