


SEC. 8 TWP. \_\_\_\_\_ RGE. \_\_\_\_\_

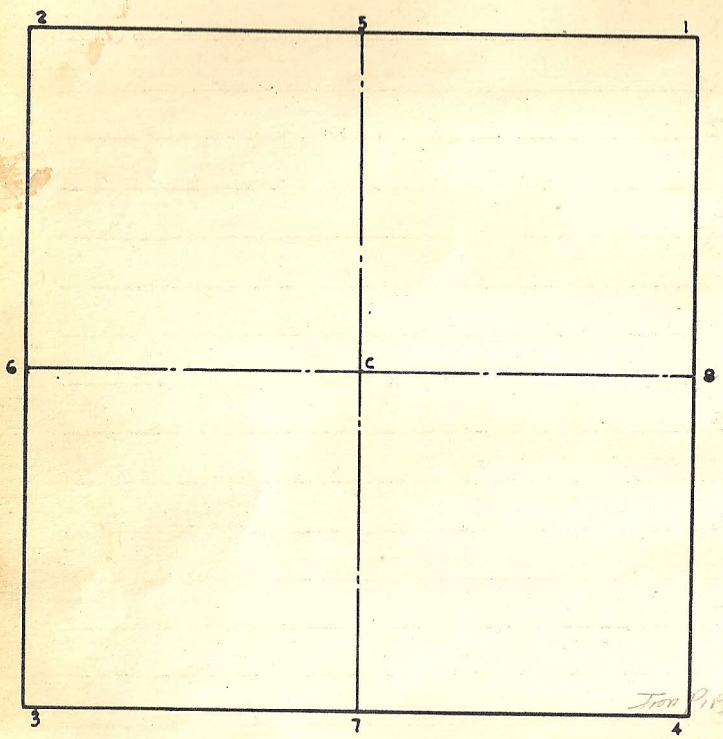

Cor: \_\_\_\_\_  
Remarks \_\_\_\_\_  
\_\_\_\_\_  
\_\_\_\_\_  
\_\_\_\_\_  
\_\_\_\_\_  
\_\_\_\_\_

1 \_\_\_\_\_  
\_\_\_\_\_  
2 \_\_\_\_\_  
\_\_\_\_\_  
3 \_\_\_\_\_  
\_\_\_\_\_  
4 <sup>10</sup>OK/B7 \_\_\_\_\_  
\_\_\_\_\_  
5 \_\_\_\_\_  
\_\_\_\_\_  
6 \_\_\_\_\_  
\_\_\_\_\_  
7 \_\_\_\_\_  
\_\_\_\_\_  
8 \_\_\_\_\_  
\_\_\_\_\_  
c \_\_\_\_\_  
\_\_\_\_\_  
\_\_\_\_\_  
\_\_\_\_\_  
\_\_\_\_\_  
\_\_\_\_\_