


SEC. 9 TWP. RGE.

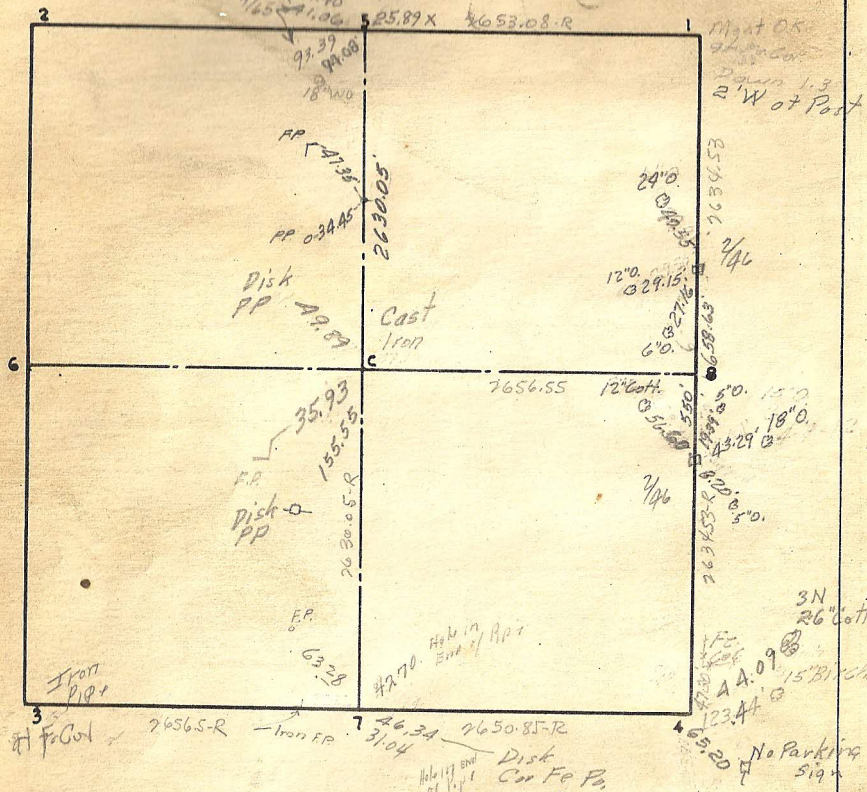

Cor: Remarks

Iron above OK 1/19
Granite

2

3 OK 10/39

Granite 4 OK 10/39 2/46 5/68

5 OK 10/39

6

Boat Spike over Granite 7 OK 10/39 2/46 4/65

8 Tub

Cast Iron C OK 10/39 2/46 4/65

Me OK 1/19