SEC. 10 TWP. ___ RGE. ___

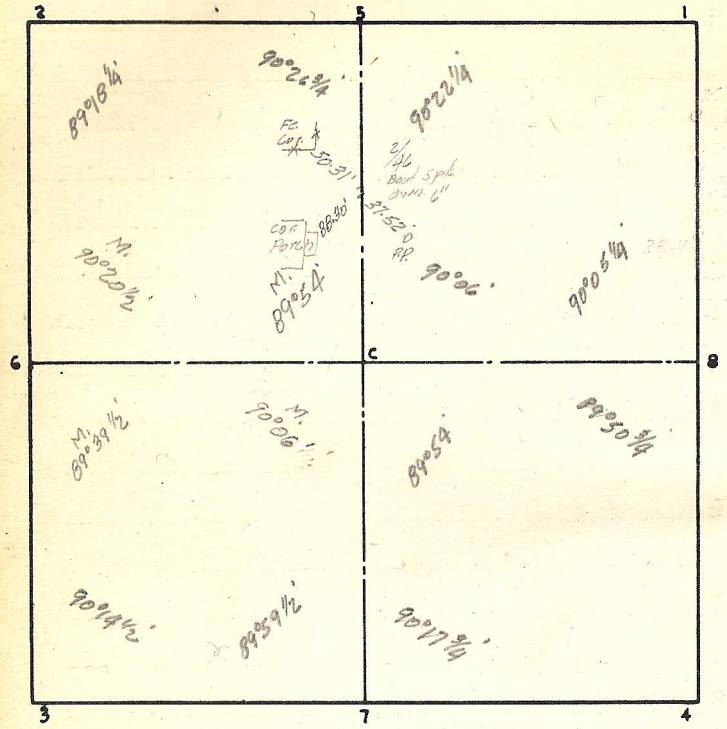

Cor.	Remarks

1 _____

2 _____

3 _____

4 _____

5 _____

6 _____

7 _____

8 _____

C _____