


SEC. 15 TWP. RGE.

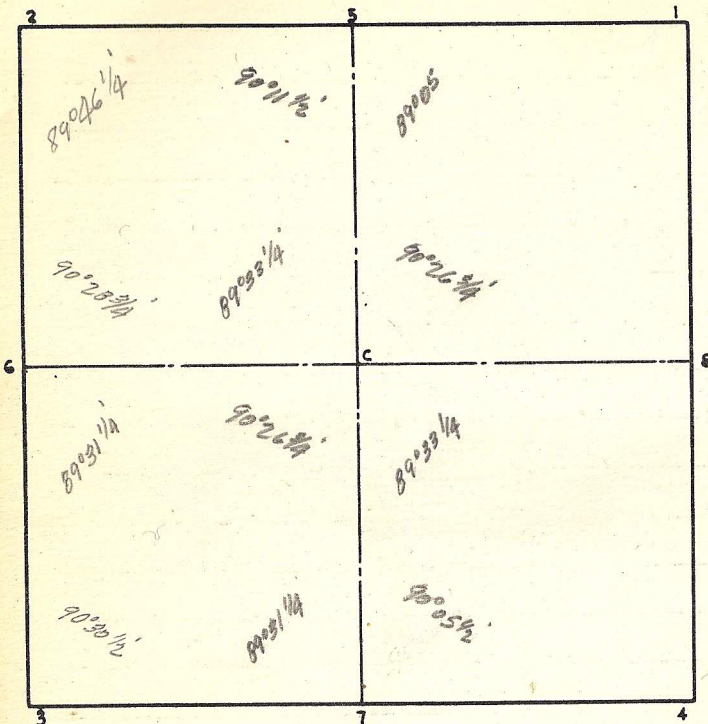

Cor:

Remarks

1 _____

2 _____

3 _____

4 _____

5 _____

6 _____

7 _____

8 _____

C _____
