SEC. 15 TWP. RGE.

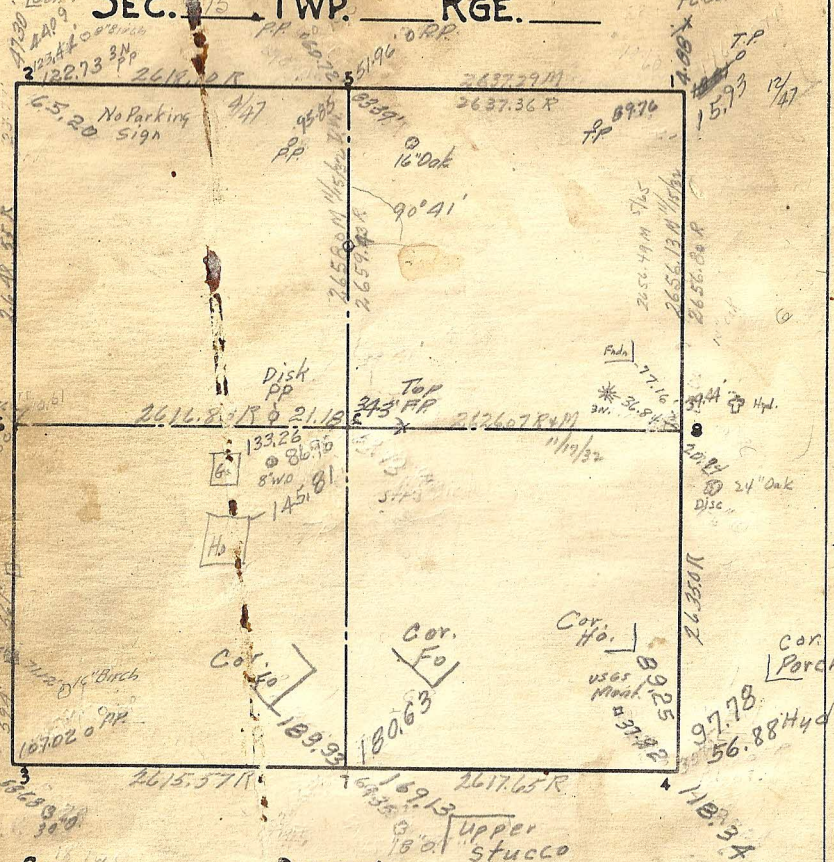

Cor.	Remarks
C	Re Est by Intersection 11-15-32 Don
C	Found Mont 4-2-34 Raised 4-2-34 Don.
4	Set Mont. (4-24-34)
C	Re Est by Intersection 11-3-37 D A
# 8	Placed iron Mont 5/16/65 R26

Granite 1

Granite 2 5/68 James La Bore

Iron in Granite 3 OK 10/39 8/66

4 OK 10/39 New Ties 8/65 FK

5 OK 10/39

6 OK 10/39

Granite 7 OK 10/39 2/46 6/65

8 OK 10/39 New ties 5/65 R26

Granite C 2/45 6/65