SEC. 17 TWP. ___ RGE. ___

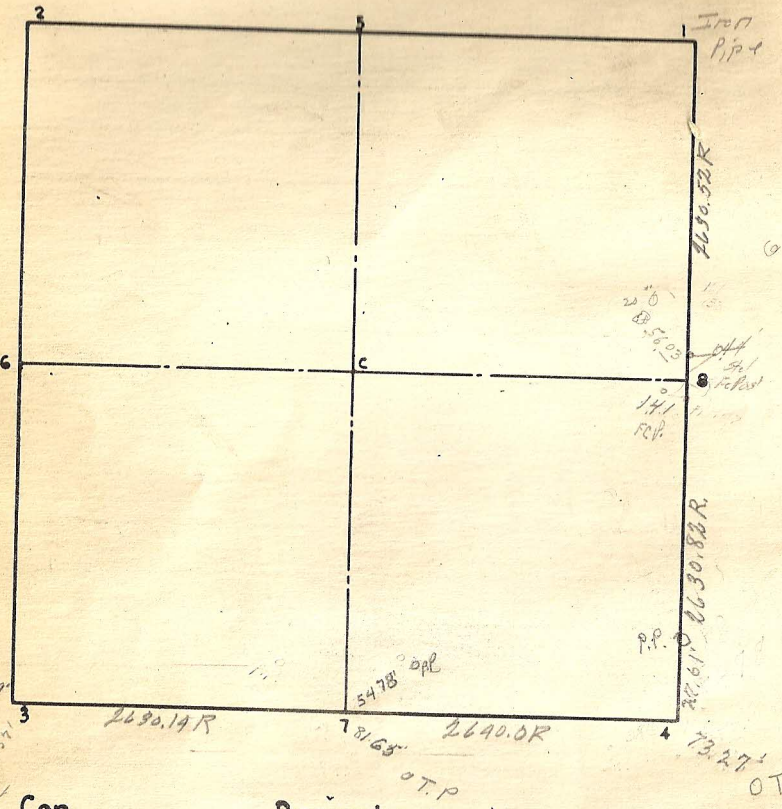

Cor:	Remarks

1 OK 10/39

2

3 OK 12/43

4 OK 10/39 2/4L

5

6

7 OK 2/4L

8

C