SEC. 19 TWP. ___ RGE. ___

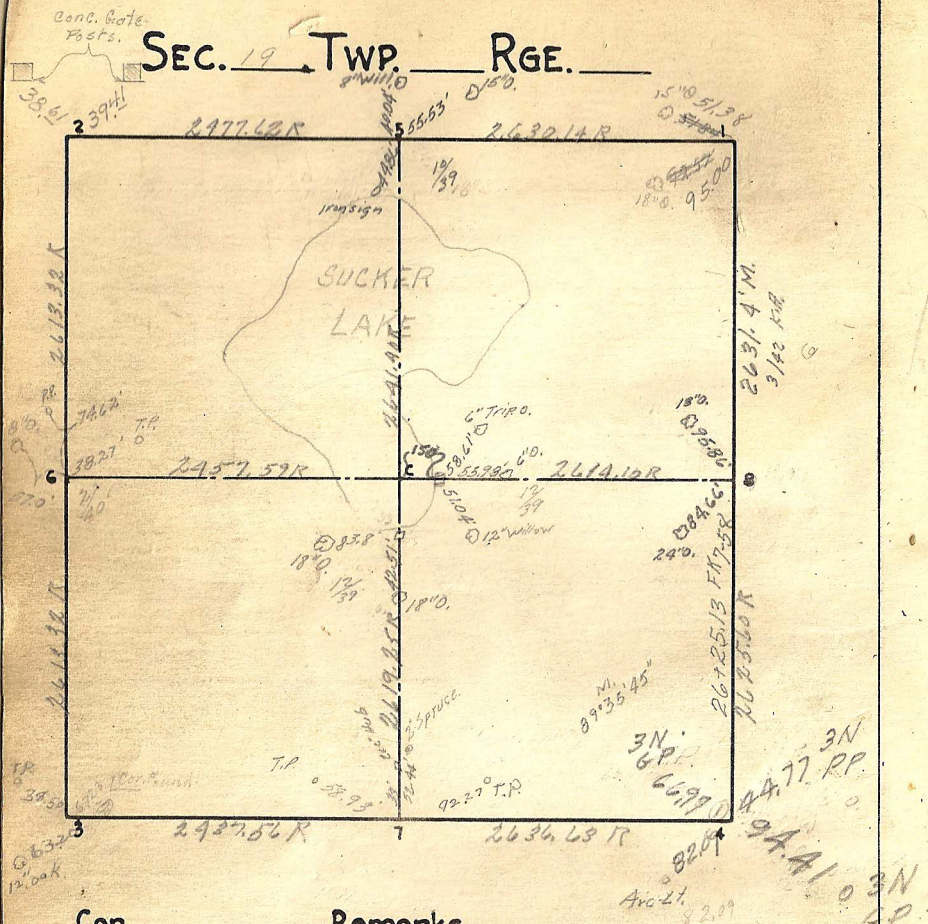

Cor.	Remarks
4	Re-set. 11-18-33 Don.
7	Reset using ties 11-2-37 K.A.

1 OK 12/43 New 4/57

2

3

4 OK 12/43

5 Iron Mon OK 12/43

6 Found Ties and Drill Hole in Rock 2-26-40
Placed Iron Mt. 10-16-40

7 OK 11-27-39 Mt. Seemed Tipped Tipped Tree

8 OK 12/43

C