


SEC. 21 TWP. RGE.

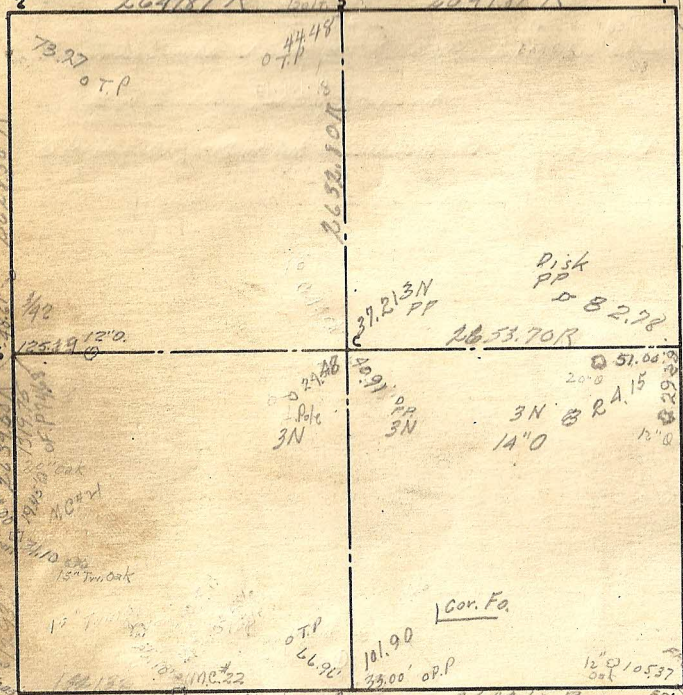

Cor. Remarks


- 1
- 2 OK 1/37
- 3 OK 1/39
- 4 OK 1/39
- 5 OK 1/39
- 6 Rest.

- Granite 7 OK 1/39 9/65
- Granite over Iron Pin 8 OK 1/39 9/65 11/70 Rest
- Granite C OK 1/39 9/65
- Mo #21 OK
- Mo #22 OK