SEC. 24 TWP. ___ RGE. ___

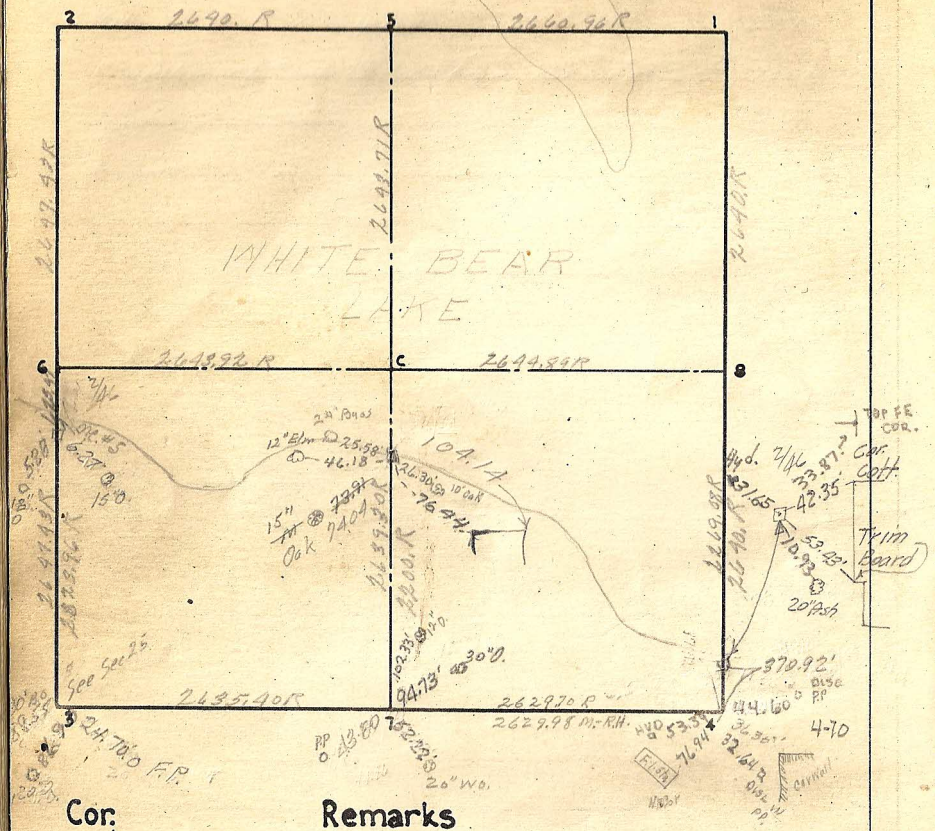

Cor.	Remarks

1 In Lake

2 In Lake

3 OK 10/39 Raised 2/46

Granite 4 OK 10/39 2/46

5 In Lake

6 In Lake

7 OK 10/39 2/46

8 In Lake

C In Lake

Mo #7 OK 10/39

Mo #6 OK 10/39

Mc #5 OK 10/39

Mc #39 Manitou Island

Mc #40