


SEC. 25 TWP. ___ RGE. ___

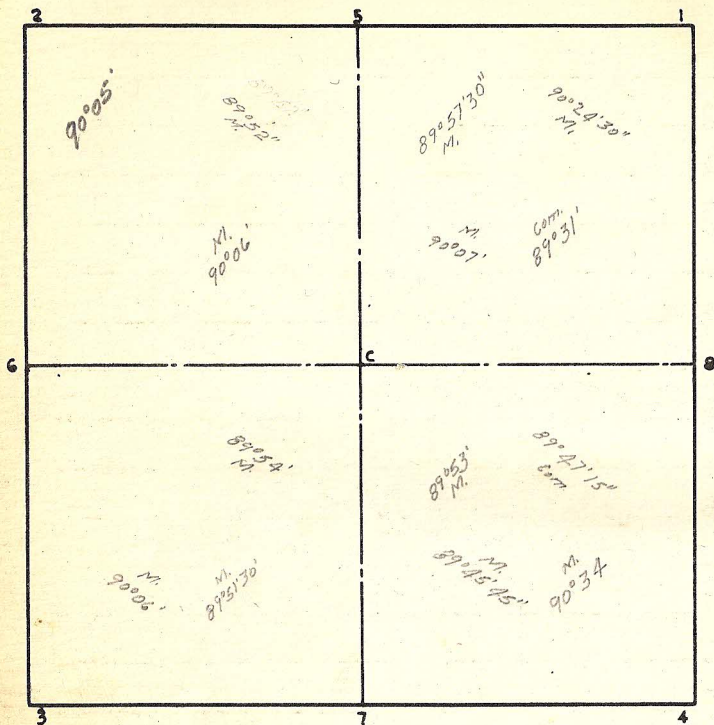

Cor:

Remarks

1 _____
 2 _____
 3 _____
 4 _____
 5 _____
 6 _____
 7 _____
 8 _____
 C _____

