SEC. 25 TWP. 26 RGE. 22

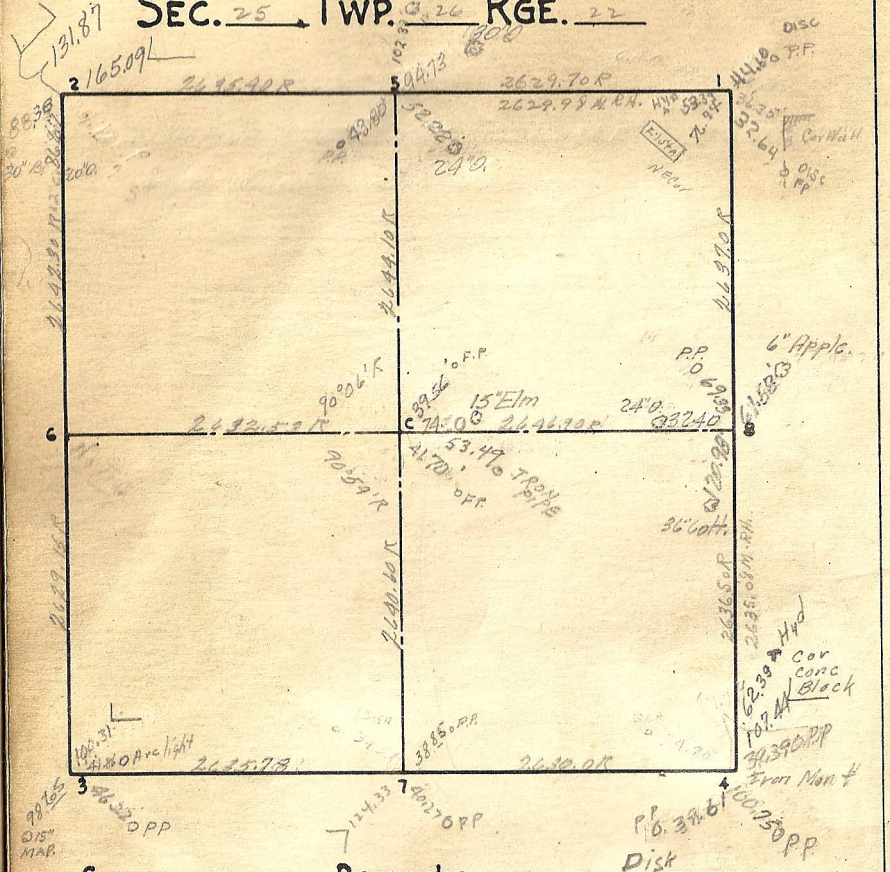

Cor.	Remarks

1 OK 10/39 2/46

2 OK 10/39 2/46 New Tie 5/57 (MM constructed over point 4/58)

3 OK 10/39 2/46 4/58

4 OK 10/39 2/46 4/58 4/70 Fk

5 OK 10/39 2/46

6 10/39 Replaced Sandstone Mon't with Granite Mon't

7 OK 10/39 2/46 4/58

8 OK 10/39 2/46 4/70 New Tk Ecorse

C OK 10/39 Found Mon't 2/46