SEC. 26 TWP. 30 RGE. 22

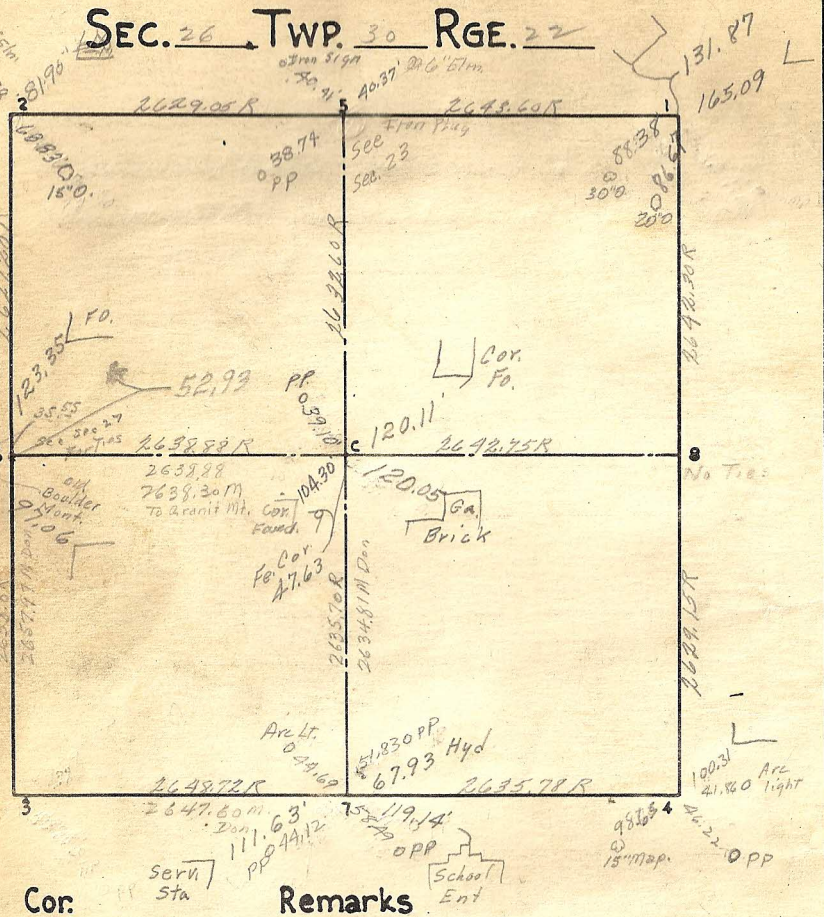

Cor.	Remarks

1319.15
17.78
1336.93

1 OK 10/39 Raised 2/46. New Ties 5/57

2 OK 10/39 2/46

3 OK 10/39 2/46

4 OK 10/39 2/46 4/58

Iron Pin 5 OK 10/39 2/46 9/66

6 OK ~~10/39~~ See Sec 27 For Ties ~~2/46~~ 7/59

7 OK 10/39 2/46 4/58

8 OK 10/39 Replaced Sandstone Mont with Granit

C OK 10/39 2/46 7/67