


SEC. 28 TWP. RGE.

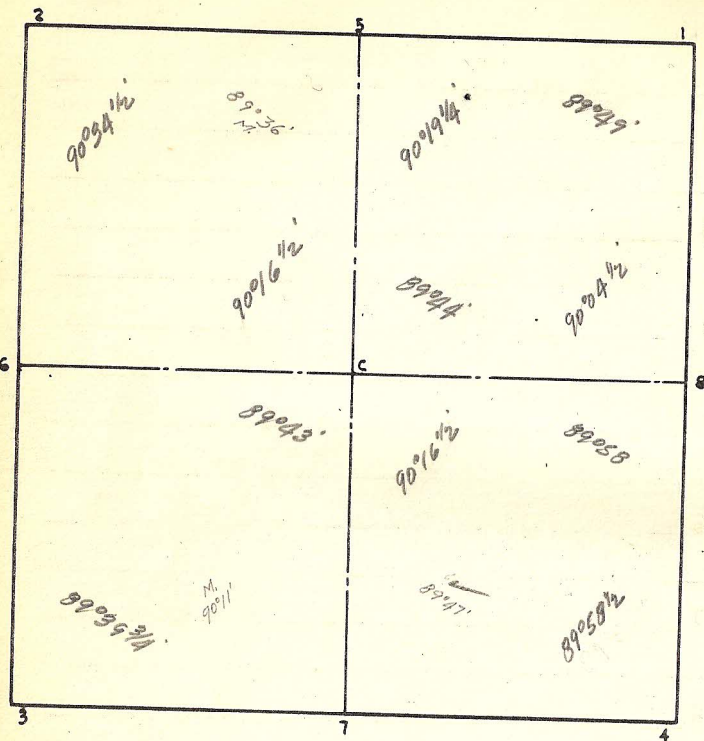

Cor:

Remarks

- 1 _____
- 2 _____
- 3 _____
- 4 _____
- 5 _____
- 6 _____
- 7 _____
- 8 _____
- C _____