443.13

SEC. 28 TWP. ____ RGE. ____

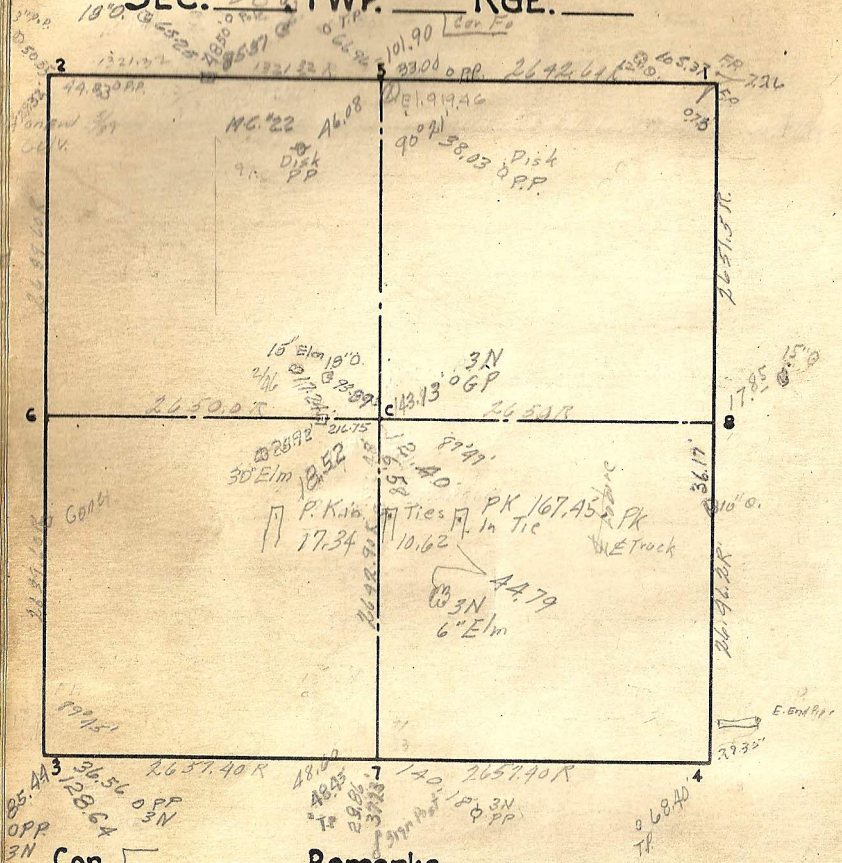

Granite

1 OK 10/39

2 OK 12/43 ✓

3 5/59

4 OK 10/39

5 OK 10/39 4/64

6 In Lake

7 OK 10/39 8/66

8 OK 10/39

C OK 10/39 Raised 1943 2/46 7.47' N. of N rail of RR Track

Mg on E&I West Line OK

Mg #22 OK 12/43

Mg #23 Re Set