SEC. 29 TWP. ___ RGE. ___

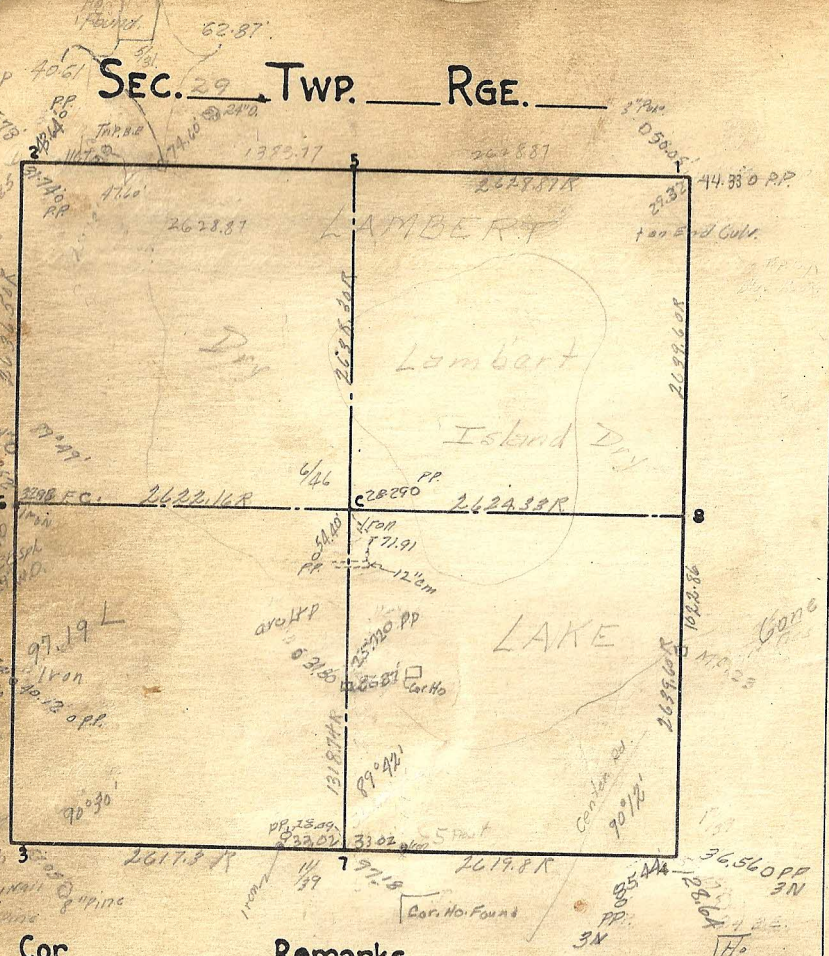
LAMBERT
Lambert Island
LAKE
2628.87
2622.16R
2624.33R
2619.8R
2619.8R
2628.87R
2638.68R
