SEC. 30 TWP. ____ RGE. ____

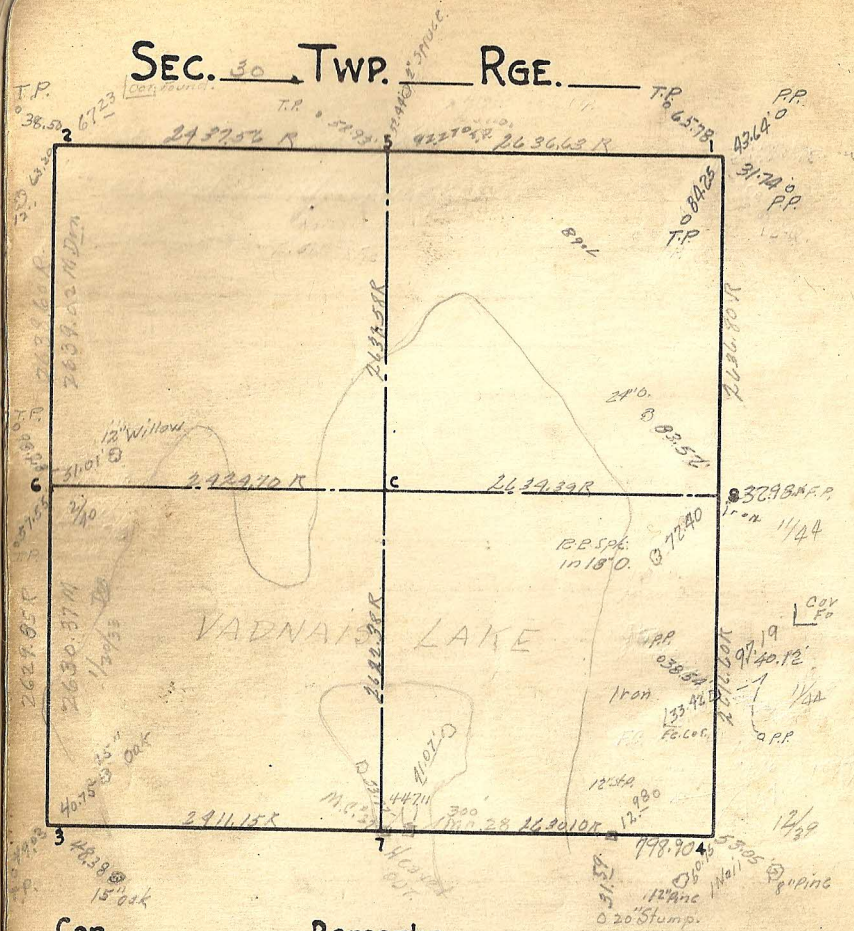

Cor.	Remarks
5	Reset using ties 11-9-37 K A

1 OK

2 OK 12/43

3

4

5 OK 12/43

6 Placed ~~Drill Hole~~ Iron Mt. 10/21/40 Opposite Nail in ℄ Pav. OK 12/43

Checks withold Ties - 2-26-40

7

8 12/39

C