SEC. 31 TWP. ___ RGE. ___

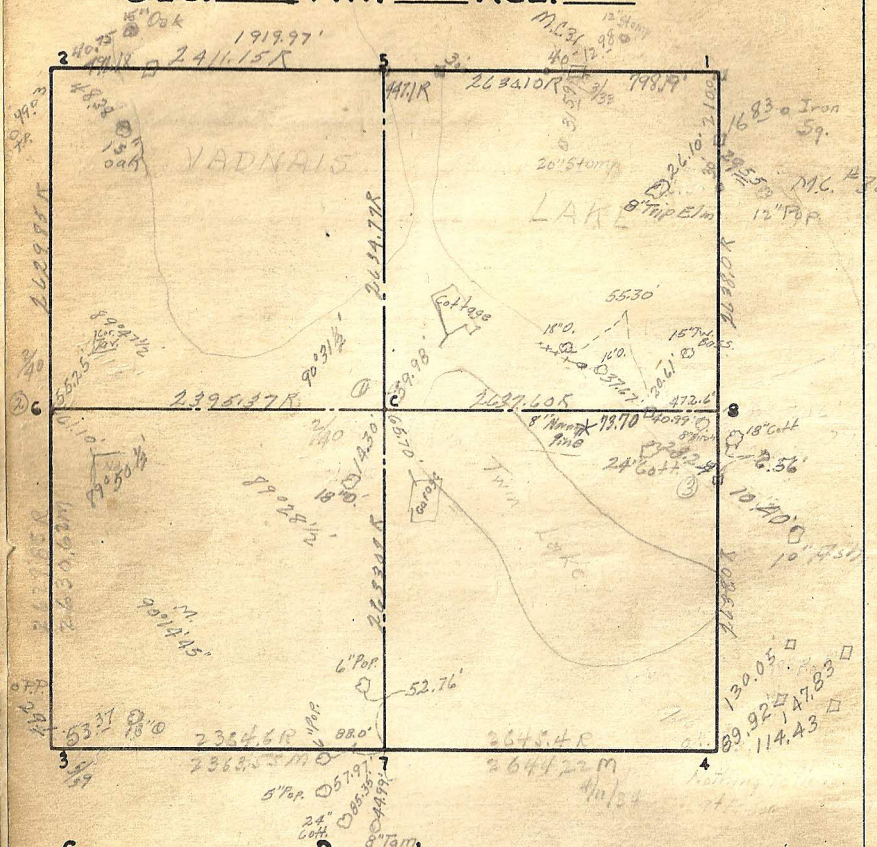

Cor.	Remarks
M.C. #30	Set back 4-24-34

1

2 OK 11-27-39

3 129.98 89.90

Granite 4 OK 3/60 11/67 90.00 C.L. State Location

5

6

7 Placed Iron - 2-26-40 - K.A.

8

C OK 11/43

8" W. Pine 3N 18" O 3N 8.72 37.6 11/67

M.C. on E-W ¼ Line

8" N. Pine 3N