


SEC. 32 TWP. _____ RGE. _____

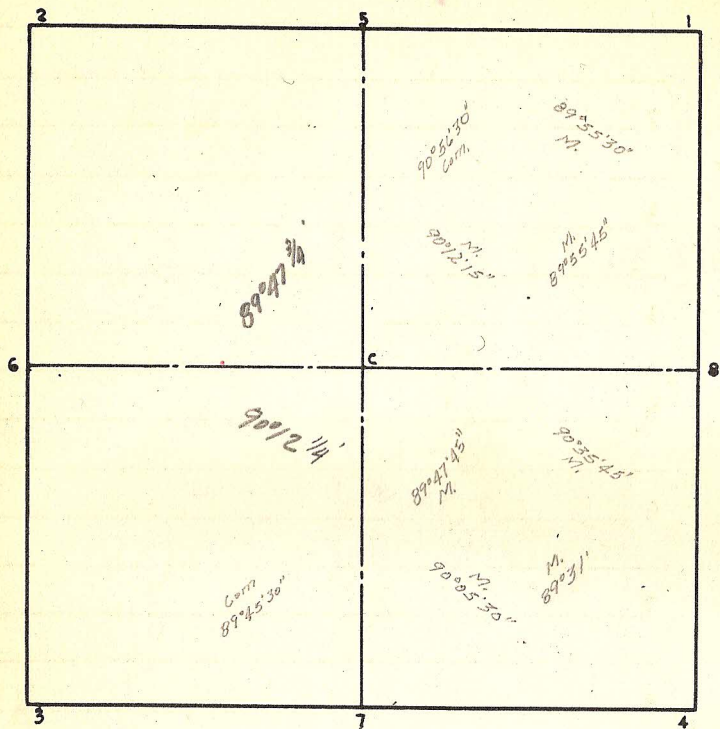

Cor:

Remarks

1 _____
2 _____
3 _____
4 _____
5 _____
6 _____
7 _____
8 _____
C _____

