SEC. 32 TWP. ___ RGE. ___

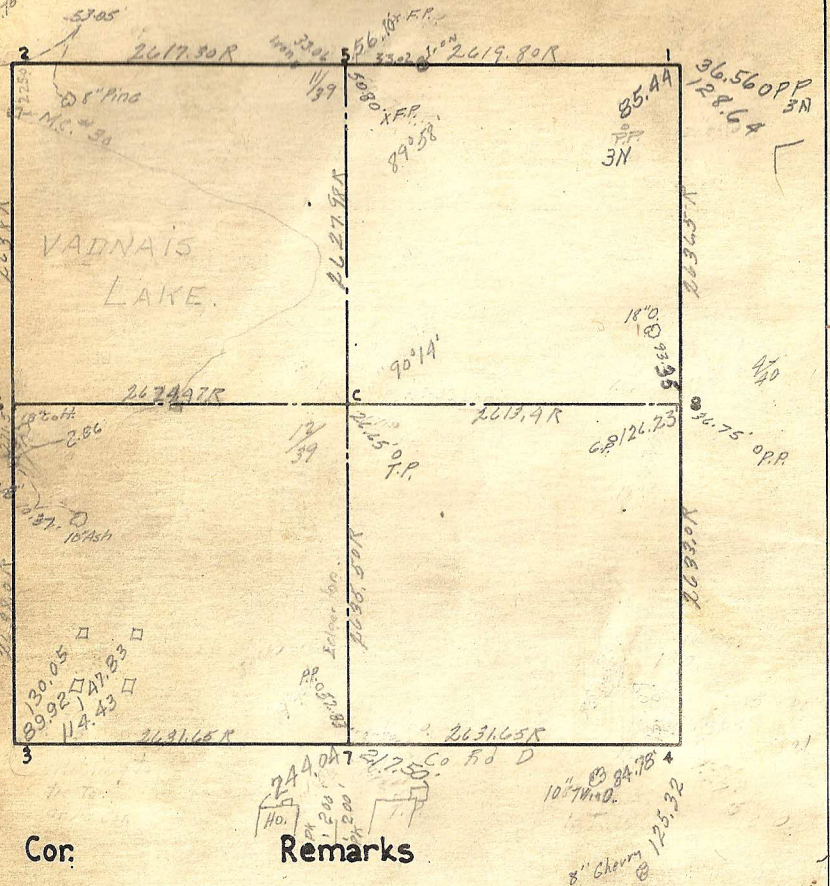
2617.30R
2619.80R
36.56 OPP
128.64
3N
85.49
3N
VADNAIS
LAKE.
2634.97R
2619.4R
2631.65R
2631.65R
2631.65