# SEC. 33 TWP. 30 RGE. 22

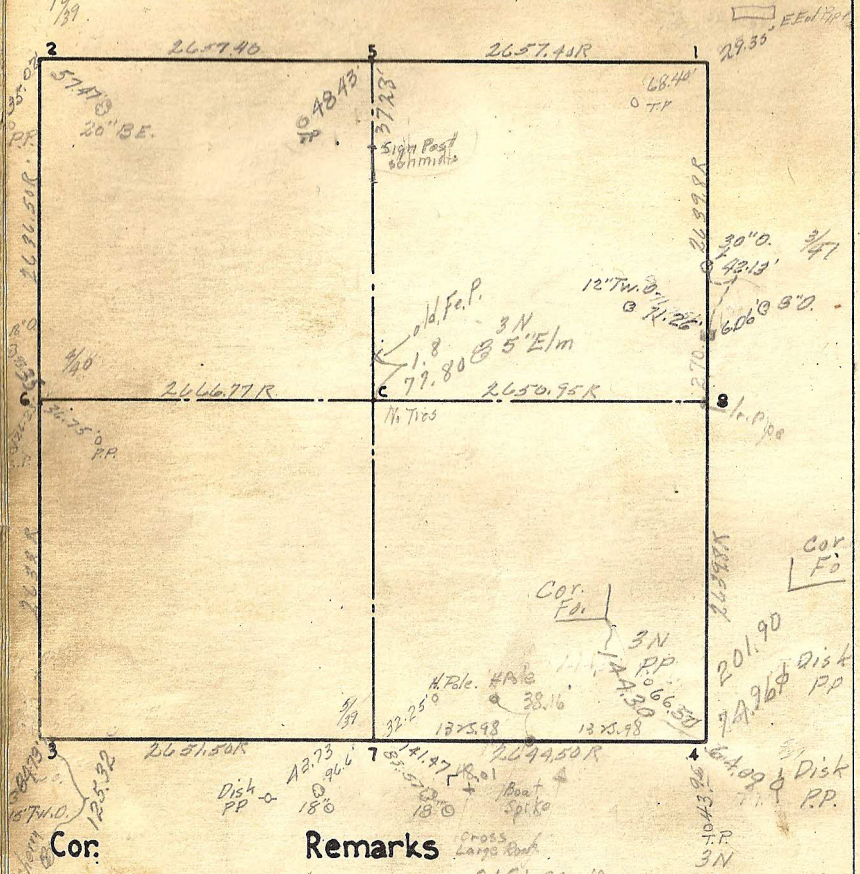


1/39

1 OK 10/39 2/46

Iron 2 2/46

3 New Ties 10/39 Reset 11/52

4 OK 10/39 2/46

5 OK 10/39 2/46

6 OK 5/45 - Reset 11/53 2/67

7 OK 10/39. OK 11/3/48 7/64 2k

8 OK 10/39

Granite C OK 10/39

Mc Between 1 & 8 OK 10/39

3 Reset Mound Using Ties 11/9/37 JCF