


SEC. 34 TWP. RGE.

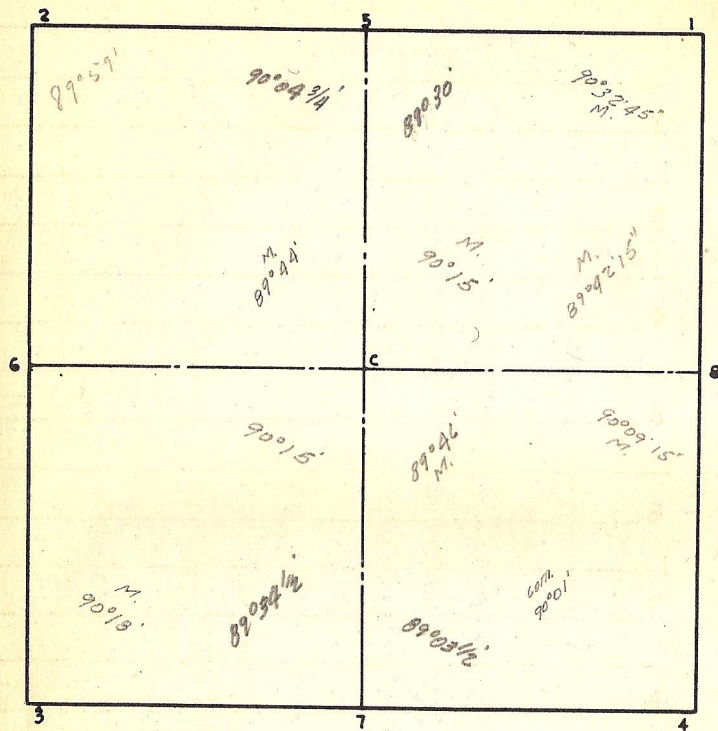

Cor:

Remarks

1 _____
 2 _____
 3 _____
 4 _____
 5 _____
 6 _____
 7 _____
 8 _____
 C _____

