


SEC. 34 TWP. RGE.

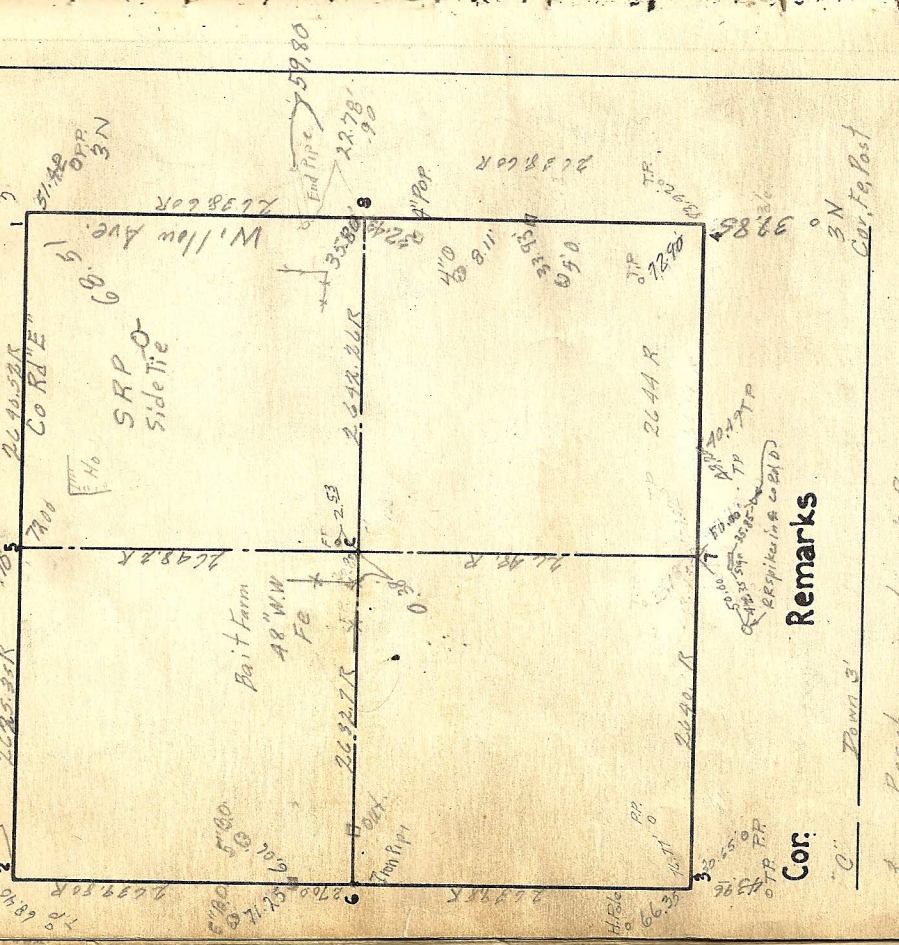

Cor: _____
 "C" _____
 3 Road using lines & H
 7 Down 0.5' 12/23 F.H.

Remarks

Granite 1 OK 10/39 246

2 OK 10/39 246

3 OK 10/39 246

4 OK 10/39 246

5 OK 10/39 246

6 OK 10/39 246

7 OK 10/39 246 4/65 New Tier. Rac

8 East N.B. 188 Placed Mark 189 243 1/65

C OK 10/39

E 1/4 of S.E. 1/4 OK 10/39

Mo. between 246 OK 10/39