SEC. 35 TWP. ____ RGE. ____

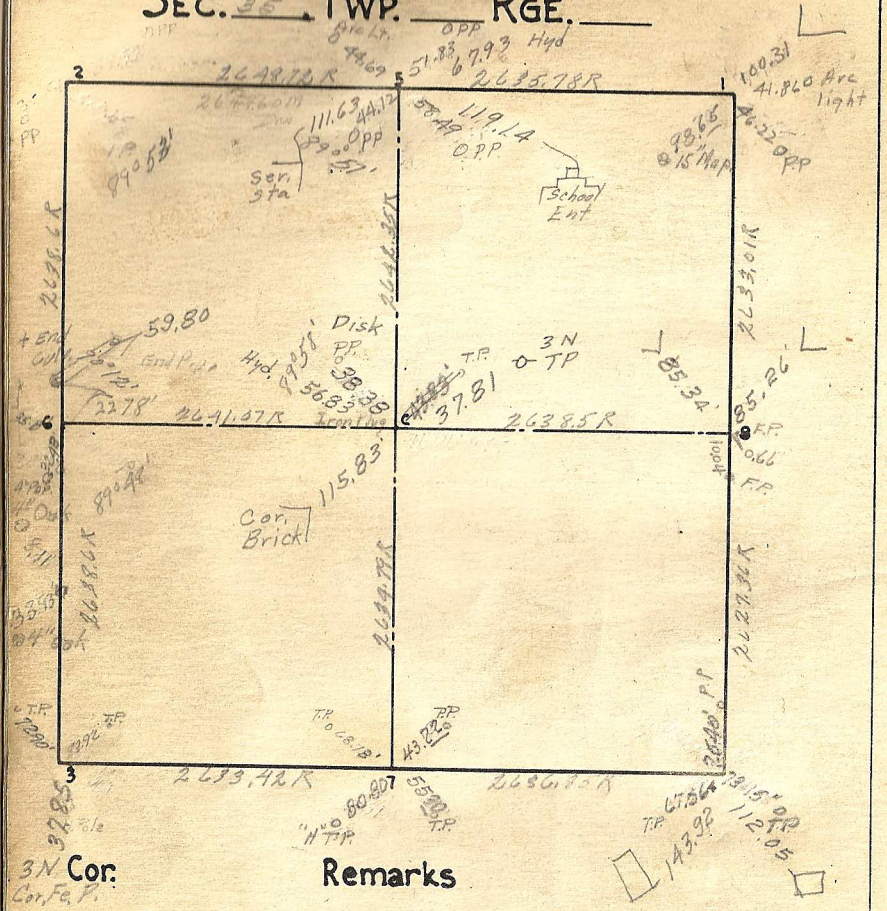

3N Cor.
Cor. Fe. P.

Remarks

1 OK 10/39 2/46 4/58

2 OK 10/39 2/46

3 OK 10/39 2/46

Granite 4 OK 10/39 2/46 1/64

Iron Pipe 5 OK 10/39 2/46 4/58 7/67

6 Est 10/38 Placed Mont 10/39 2/43 1/65

7 OK 10/39 2/46

Cal. 8 OK 10/39 1/68

Iron Plug C OK 10/39 7/67

W¼ Cor of S.W¼ OK 10/39