SEC. 36 TWP. ___ RGE. ___

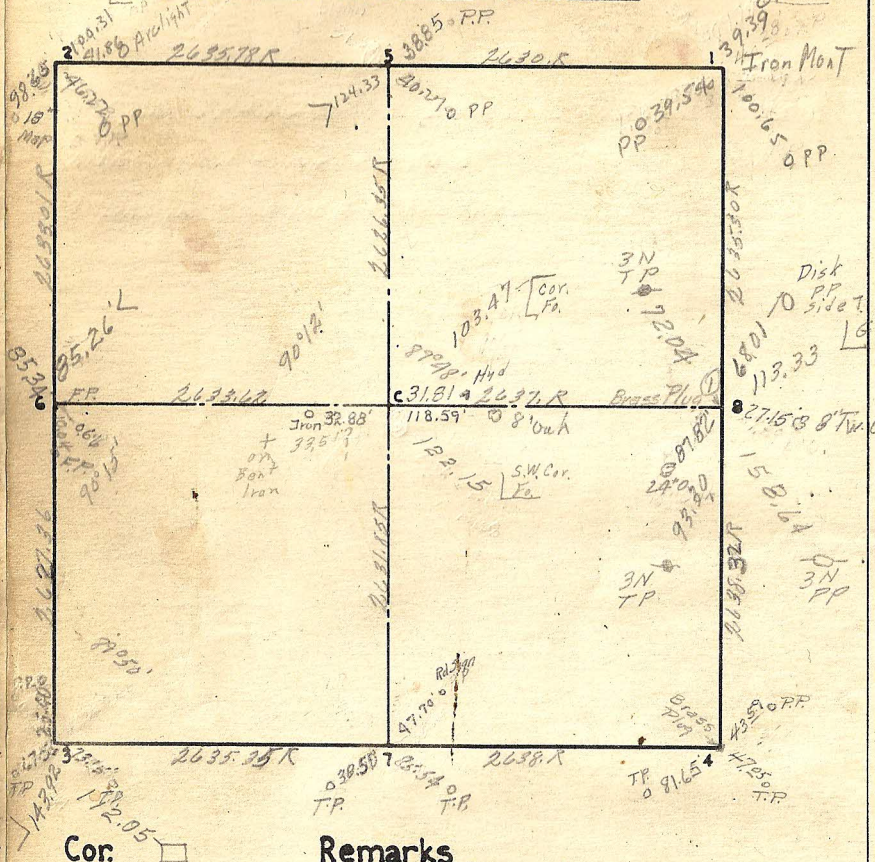
2
5
1
3
4
6
8
7
2635.78 R
2630.5
Iron Mon T
3885 P.P.
39.39
100.65 O PP
124.33
40.27 O PP
39.54 PP
O PP
98.36
85.26
90°12'
103.47
Cor. Fd.
3N T P
72.04
Disk
10 PP
Side 7
Granite
68.01
113.33
Bronze Plug
8
27.15 & 8" Tw. O.
85.36
2633.68
31.81
2637. R
118.59
8" Oak
Iron 32.88'
335°
Bent Iron
90°12'
122.15
S.W. Cor. Fd.
87.82
24°0.30
93.90
15 8.64
3N T P
3N PP
2635.32 R
2635.35 R
2638. R
30.58
T.P.
35.54
T.P.
47.70
81.65
T.P.
43.58 P.P.
42.25
T.P.
2.05
Cor.
Remarks

1 OK 10/39 4/54

2 OK 10/39 2/46 4/54

Granite 3 OK 10/39 2/46 1/66

4 OK 10/39 2/46

5 OK 10/39 2/46 4/54

6 OK 10/39

7 OK 10/39 2/46

8 OK 10/39 2/46

Granite C OK 10/39 2/46 RESE 1950 11/67