S.W. Cor. Sec. 7-30-23

Monu. No. 101

Found cast iron monu. flush and retied. Aug 19, 1974

Retied monu. 1-14-92

Retied monu. 10-17-00

Retied Monu. 12/29/04
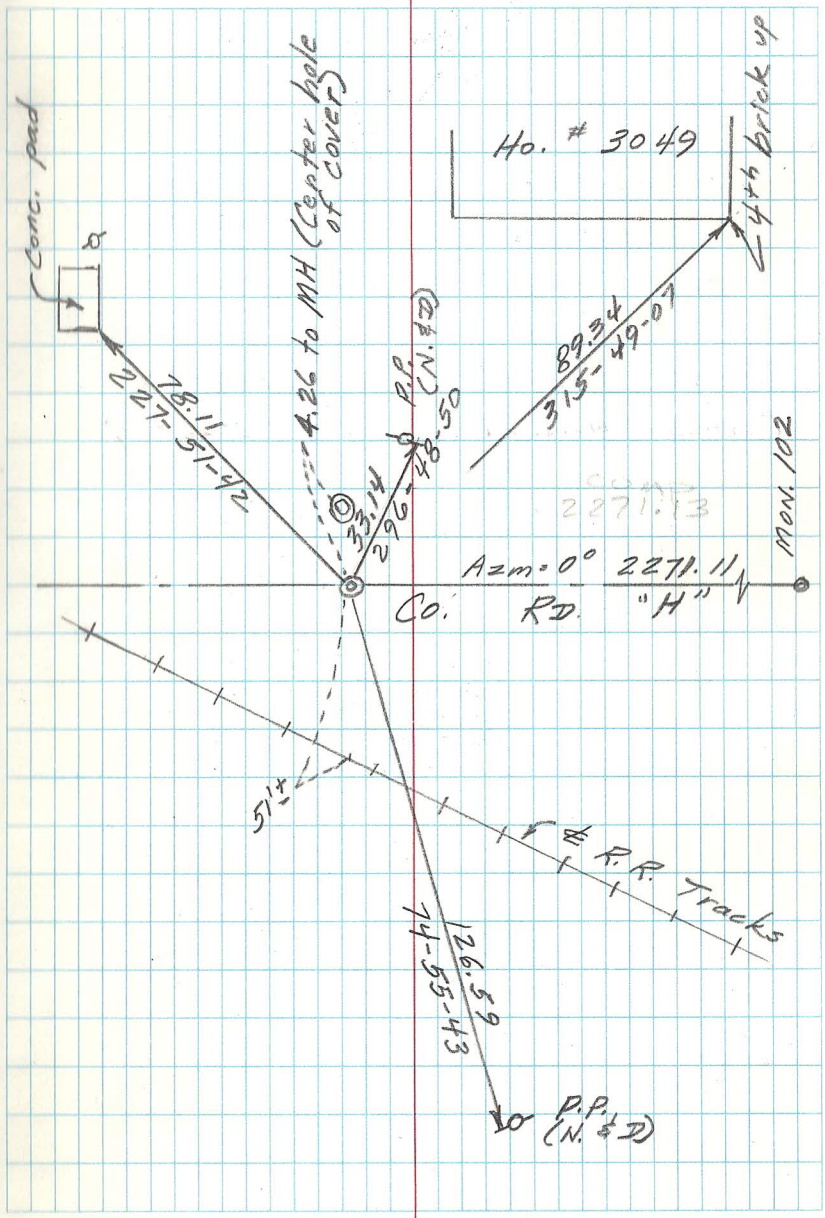
Retied Monument 10-20-09