

5 1/4 COR. SEC. 7-30-23

MONU. NO. 102

Found cast iron monu. flush and
retied. Aug 19, 1974


Retied monu. 1-14-92

Retied monu. 10-17-00

Retied Monu 12/29/04

RETIED MONUMENT 10-20-09

102

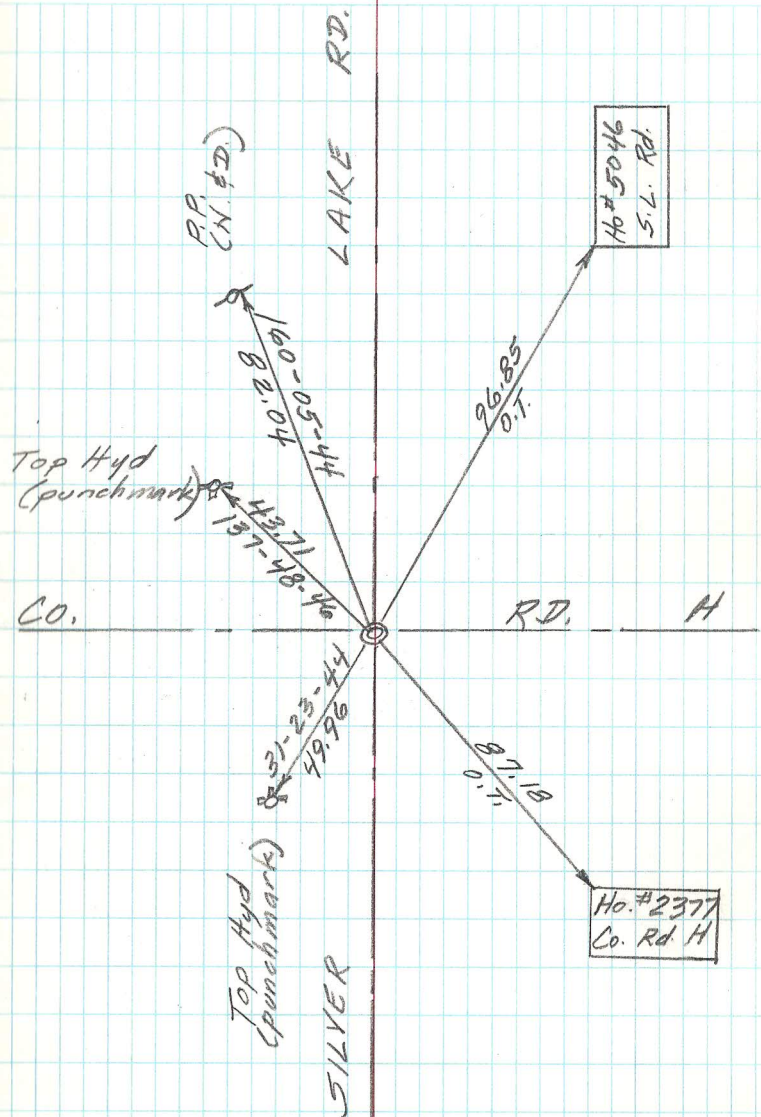

O.T. = Old Tie

MON 127