N. E. COR. SEC. 18-30-23
MONU. NO. 103
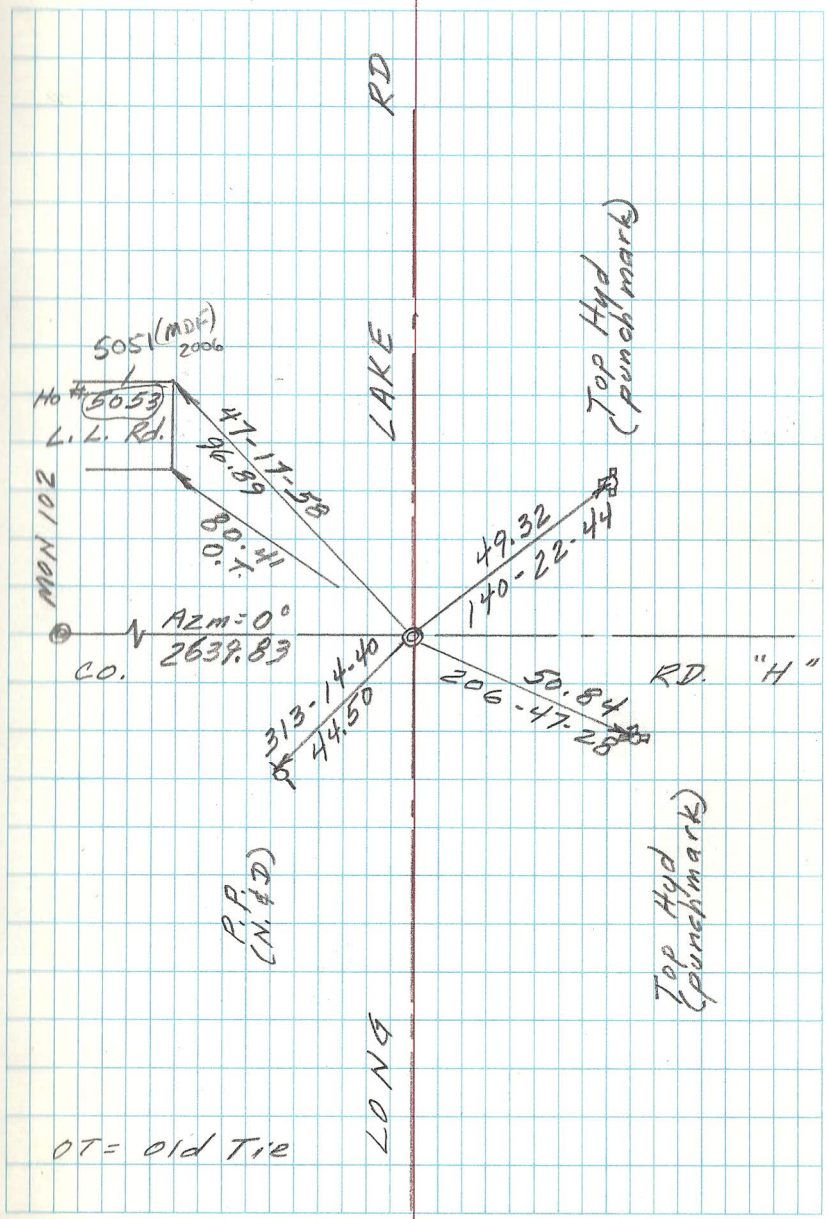
Found cast iron monu. Flush. 6-14-74
Destroyed by Construction. 1987
Relocated position, set P.K's and
retied monu. 8-26-88
Placed 20" cast iron monu. 10-1988
Retied monu.. 10-17-00
RETIED MONT. 3-08-05
RETIED MONT 12-29-04
MONUMENT, (CONCRETED) MAINTENANCE, 9-08-06
Retied monu. 6-3-10