


SOUTH 1/4 COR. SEC. 8-30-23
 MONU. NO. 104

Found cast iron flush and
 retied. Aug 19, 1974
 Retied monu. 1-14-92
 Retied monu. 10-13-00
 RETIED MONU. 3-08-05
 Retied monu. 6-3-10

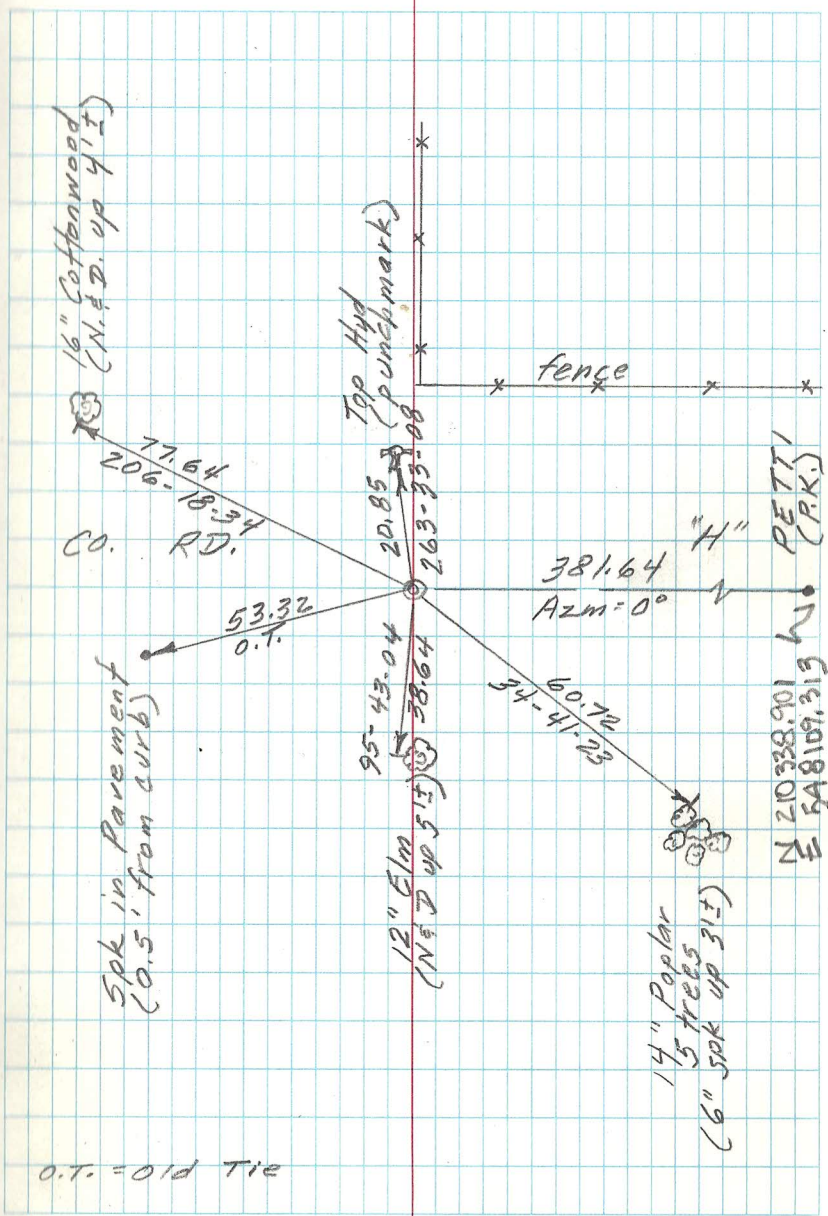

0.T. = Old Tie