NORTHEAST COR. SEC. 16-30-23
MONU. NO. 107
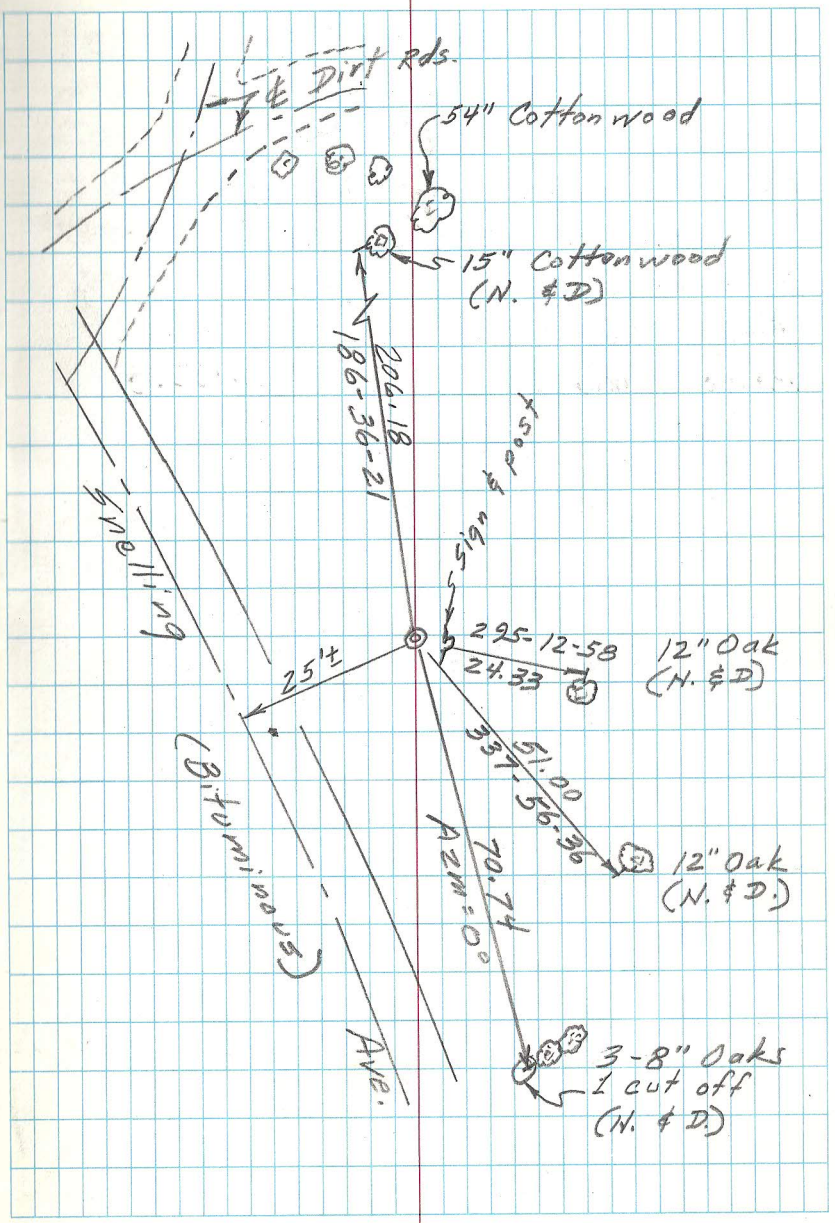
Found 1" solid iron flush off shoulder of road. Aug. 1991.
Tied monu. Aug. 20, 1991
Placed sign & post 2'± east. Aug 26, 1991
Retied monu. 4-3-01
RETIED MONT. 3-09-05
Retied monu. 9-13-10