MONU. ON EAST LINE
SEC. 7, T30, R22
MONU. NO. 115N
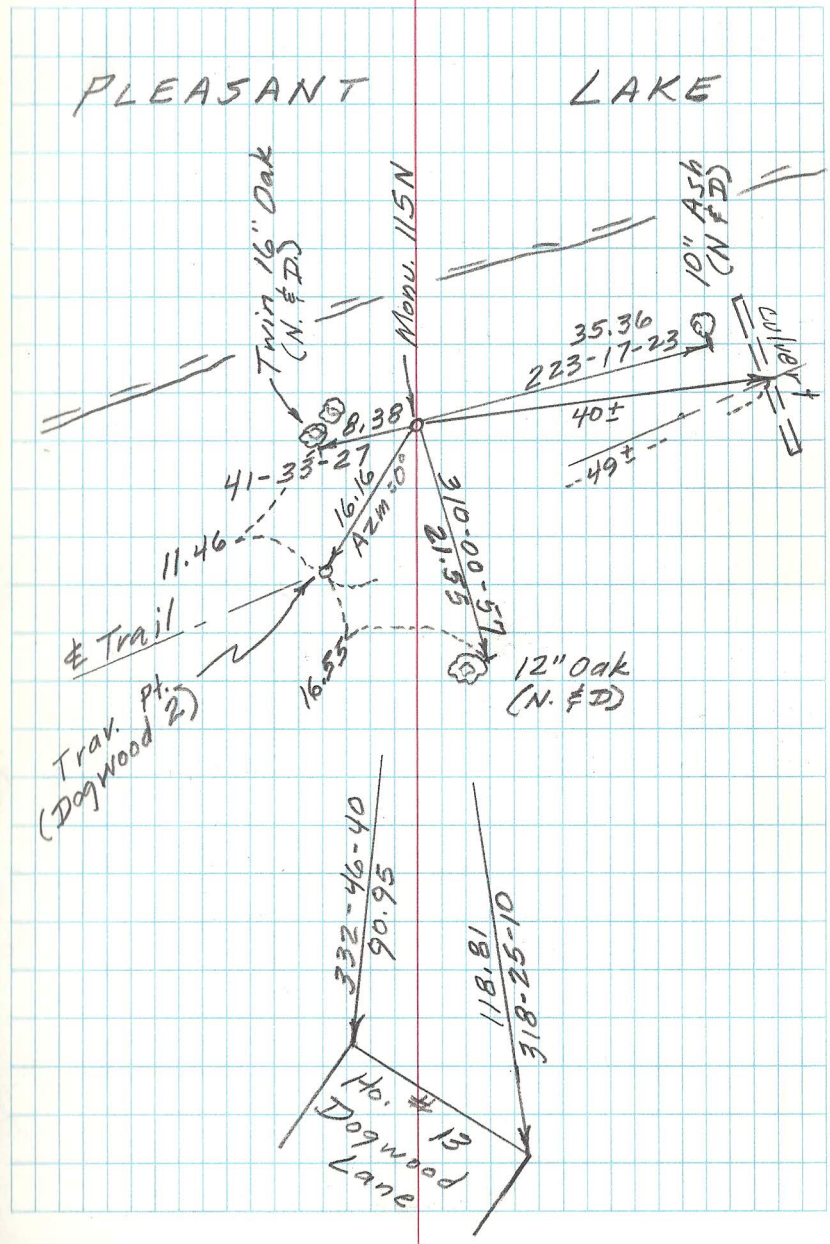
Found ½" iron in conc. set by
Milner W. Carley & Assoc., 5-19-91
Tied, set sign & post (0.6'S) 11-06-01