CENTER SEC. 18-30-23

MONU. NO. 127
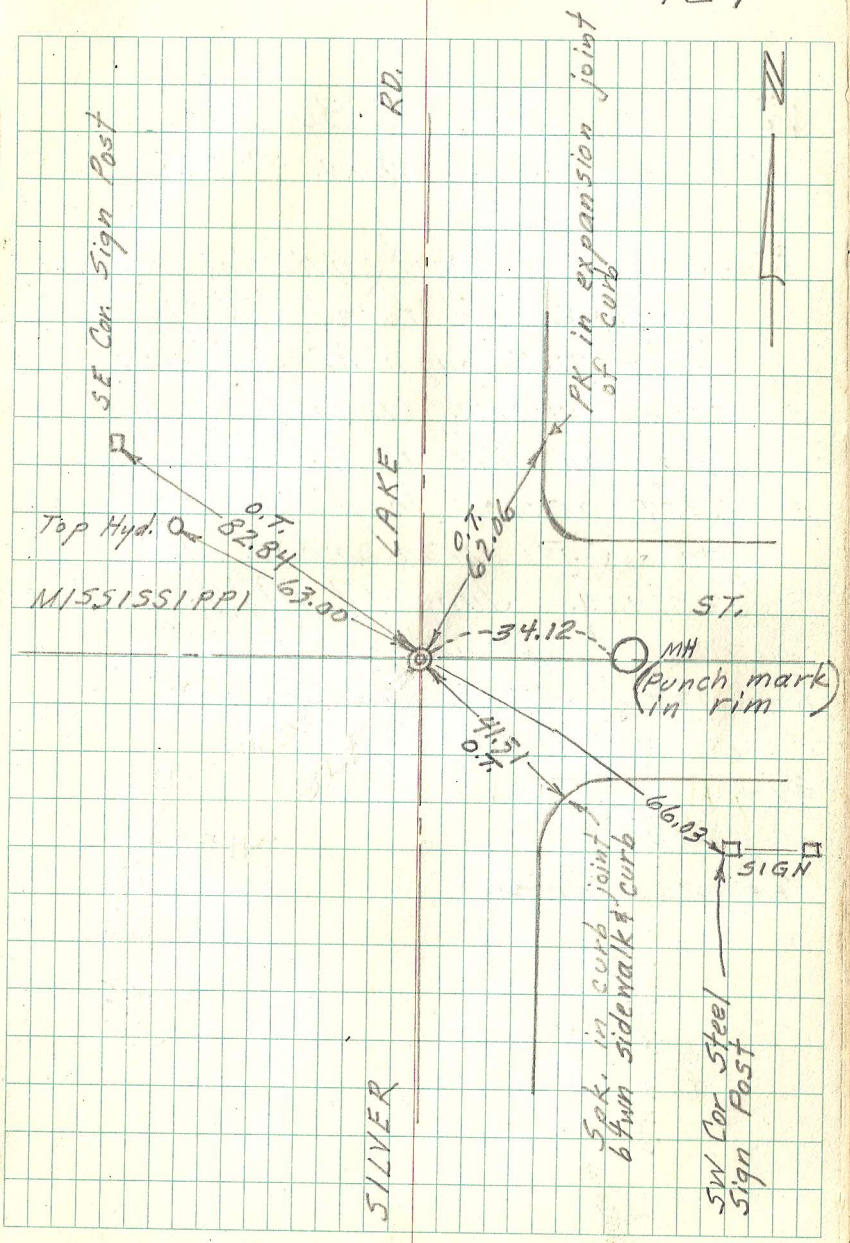
Found Cast Iron monu. flush.
June 12, 1974.
Re-tied monu. June 26, 1975.
Retied monu. 1-14-92
Removed 20" C.I.; found 1" iron 18" long 21" down. Removed iron & set 20" C.I 18" below grade in place of iron. Iron not in same place as old C.I; Set MH. assembly. 11-13-98
Tied for reconst. of Silver L. Rd. 4-12-02
Removed MH and 20" C.I.. 5-8-03
Re-set 20" C.I down 18"; contractor to set 12" tube and MH assembly. 11-17-03
Retied March 1, 2005
Retied monu. 7-13-10