CENTER SECTION 17, T30, R23
MONU. No. 129

Found granite monu. in swamp tipped directly south. Tied monu. in Moundsview book, page 7. Sept. 9, 1975.

Replaced monu. with cast iron. Stone removed by water main constr.. May 3, 1976.
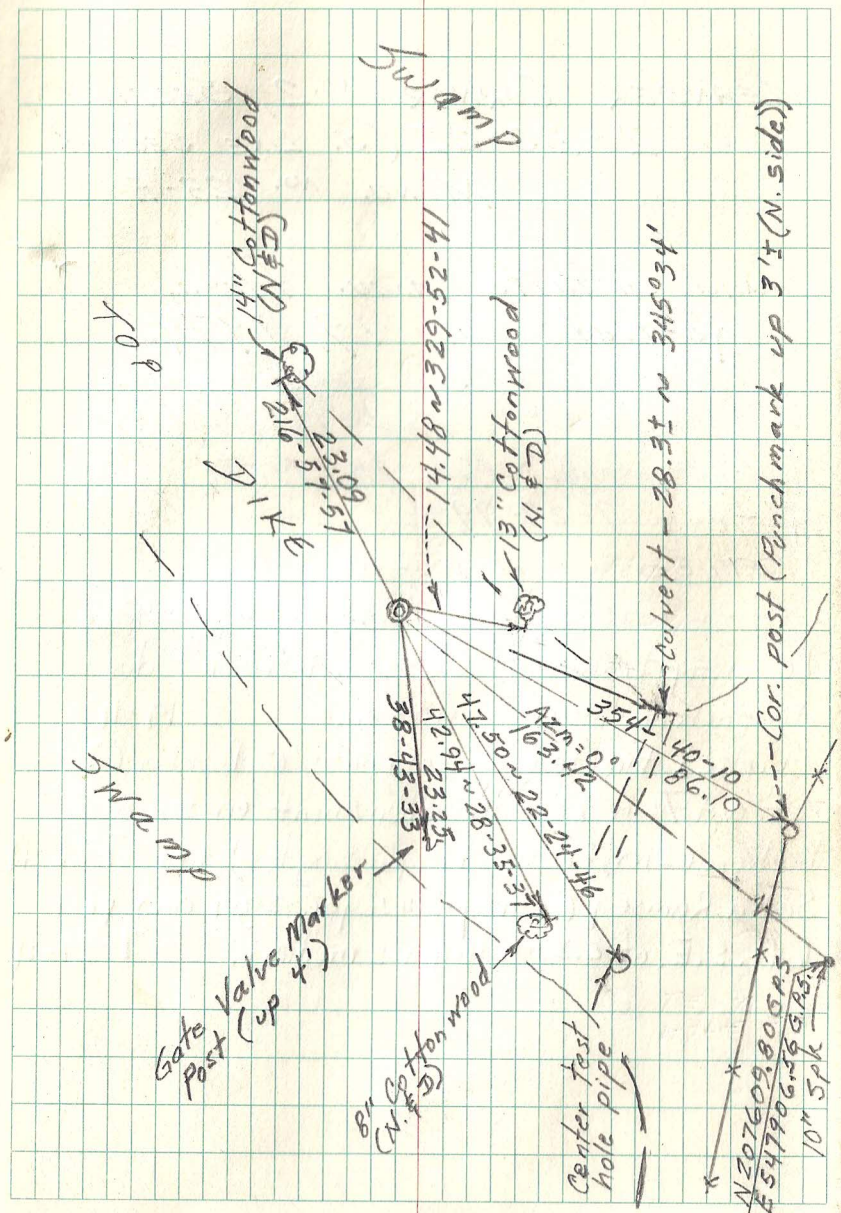
Retied monu. 7-3-03