


MONUMENT ON N. & S. 1/4 LINE
SEC. 12-30-22

Found granite flush with ground

May 17, 1974.
Re-tied June 28, 1974.
Re-tied 7-21-88

Retico Short Ties 6/12/98 IC DS
RETICO 11-05-04

124-N

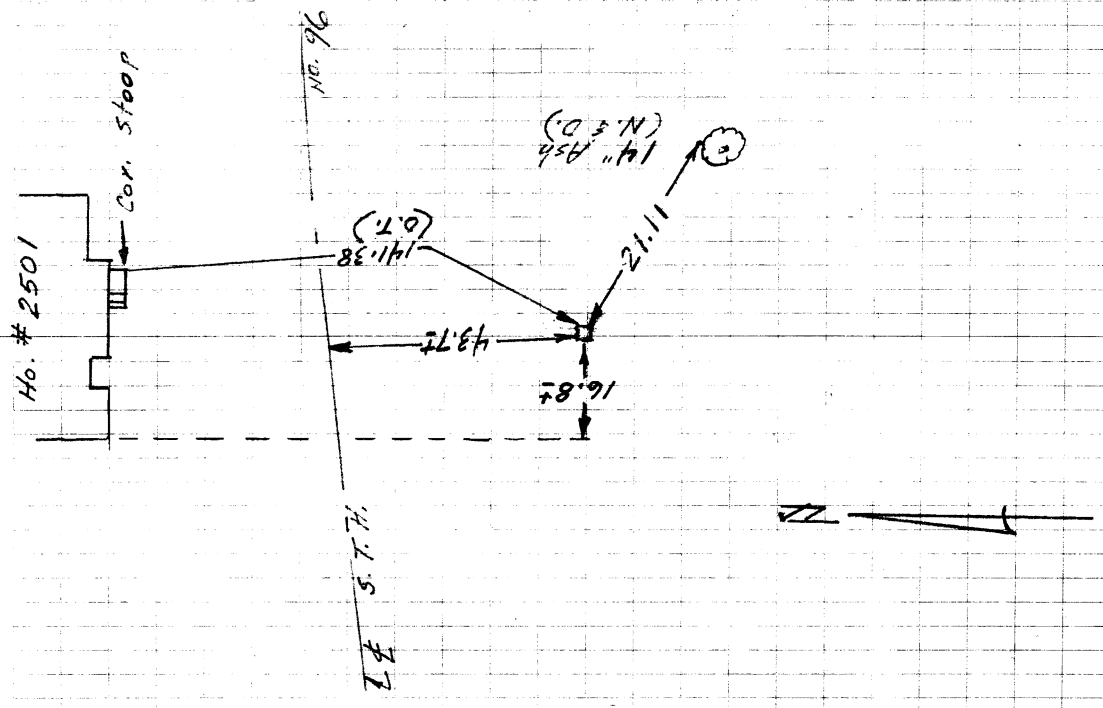

(O.T.) = old ties not checked