EAST 1/4 COR. SEC. 17, T30, R22
MONU. NO. 142

Found 1/2" I.D. iron pipe in March 1988. This iron was placed by M.W. Carley after const. of cul-de-sac.

Tied iron. 5-7-90

Iron found to be out of position. Found old irons and computed new location. Placed 20" cast iron flush; retied and placed sign and post. Aug. 28, 1991.

Retied monu. 4-28-03

Retied monu. 11-5-08
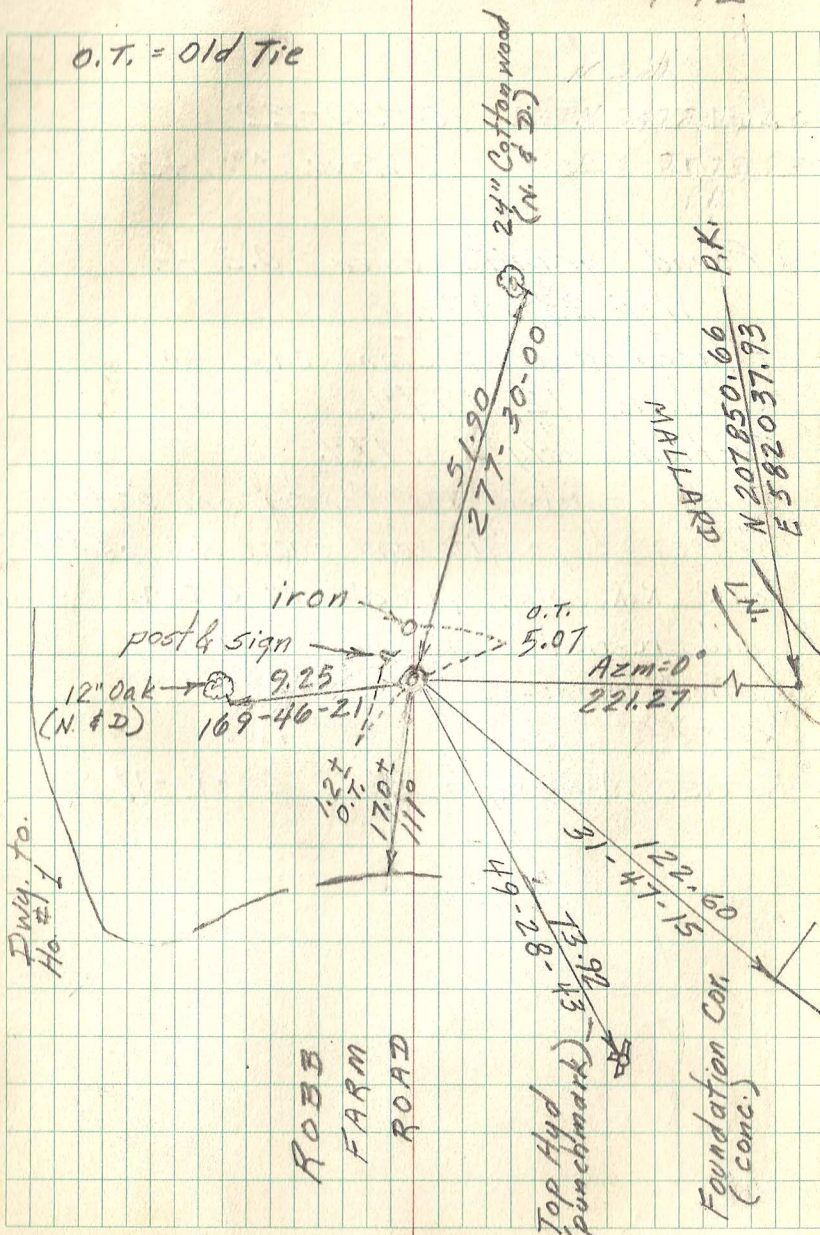
O.T. = Old Tie