S 1/4 Cor. Sec. 17, T30, R23
Monu. No. 154
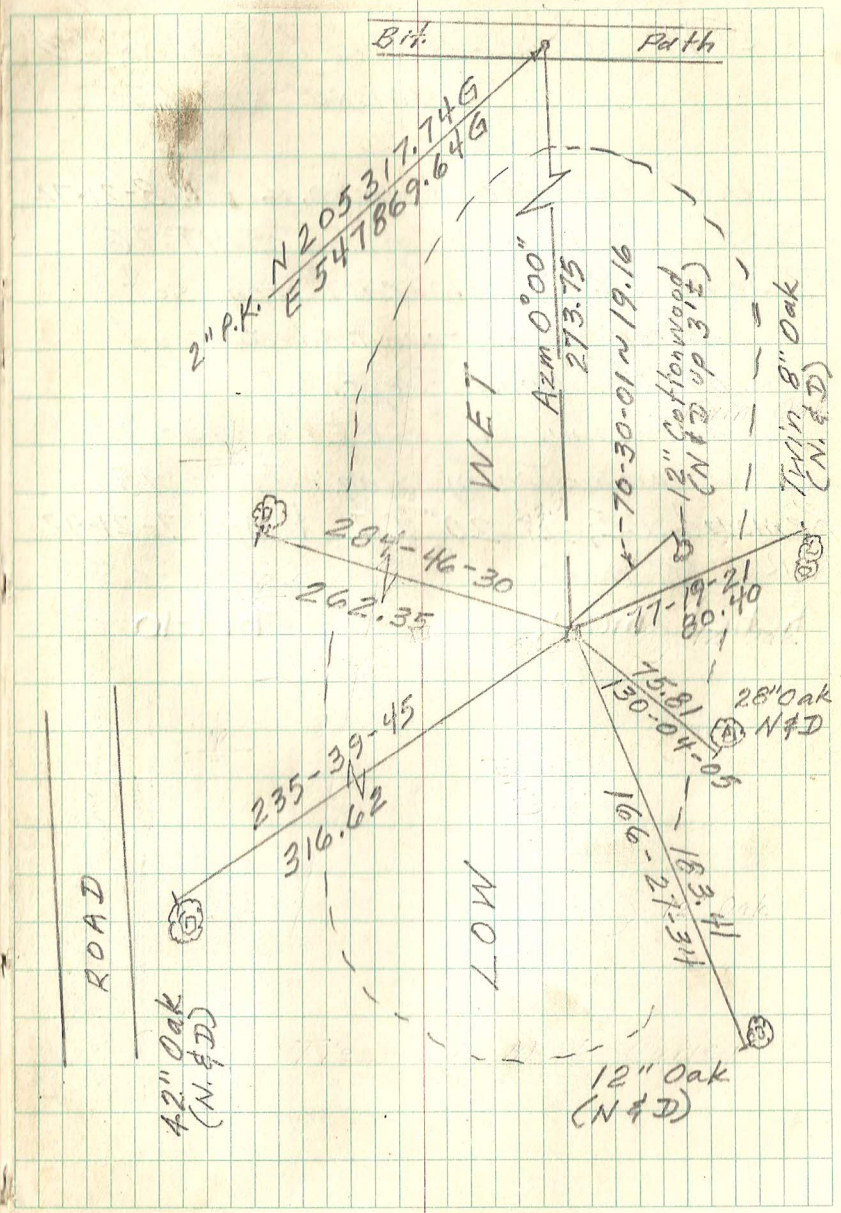
Found granite monu. down 1½± ft.
Steel post placed 1'S. Nov. 1981
Checked to see if monu. exists after Park
was built. Found Oct. 10, 1988.
Found granite monu down 1.3± ft.;
Refied & set sign & post (0.5 ft)
South adjacent to monu. 3-12-02
RETIED MONUMENT 6-04-09