MEANDER COR. NO. 4, SECTION 14, T30, R22. SOUTH LINE SEC. EAST OF S 1/4 CORNER.

MONU. NO. 172-E

Found granite monu. down 1± ft. June 12, 1975.

Tied monu. (down 2½"±). 6-15-90

Re-tied monu. (down 2"±) 9-28-99

Set sign & post. 8" S. monu. 10-25-99

RETIED MONT. 8-23-06
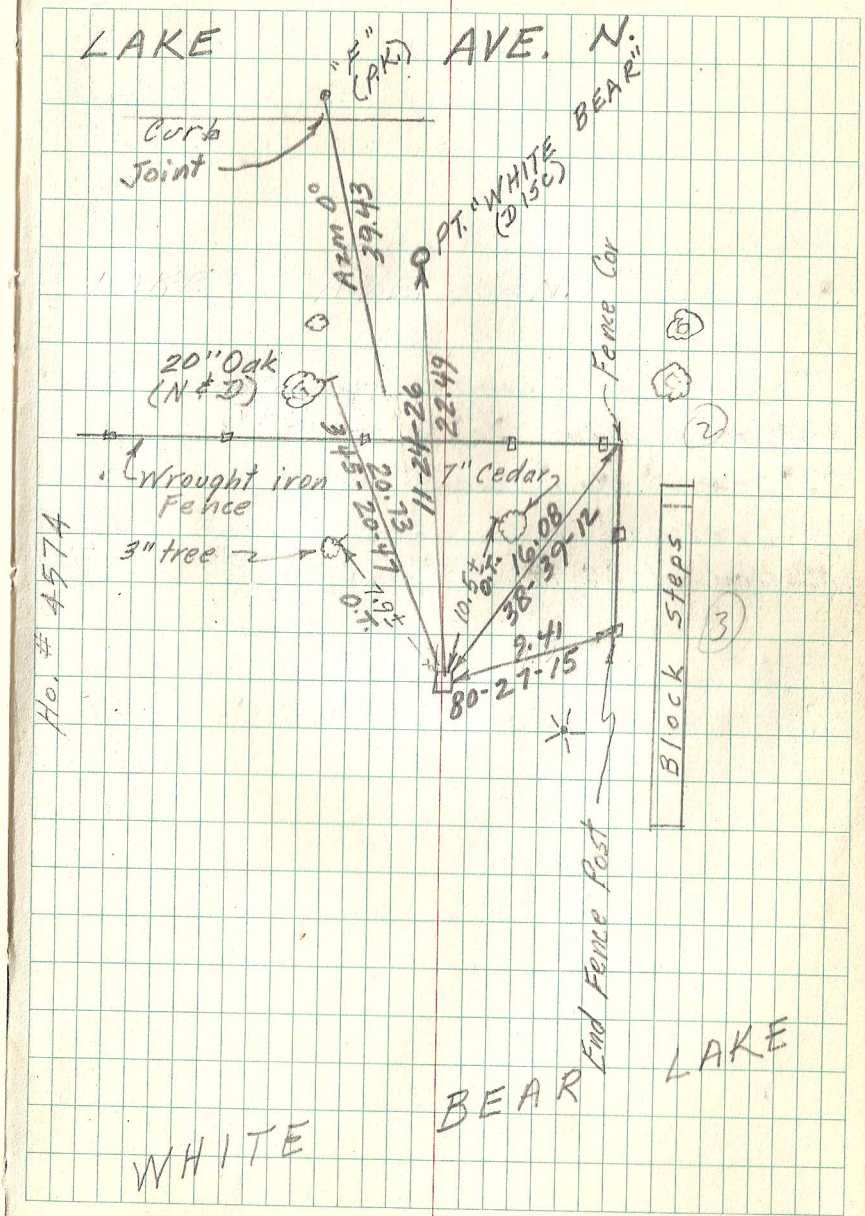
Retied mont 9-16-11