MONU. ON EAST & WEST 1/4 LINE WEST OF CENTER OF SECTION 21, T30, R 23. (4/08 GG)

MONU. NO. 180-E

Found granite monu. up 0.4 ft; retied 1975

Granite up 0.4ft.; sign and post 18" ±east of monu.; large tree lying on top of monu.. 10-1-93

RETIED MONT (UNDER WATER NOT DONE ✓) 3-15-05

RETIED MONUMENT 4-16-08
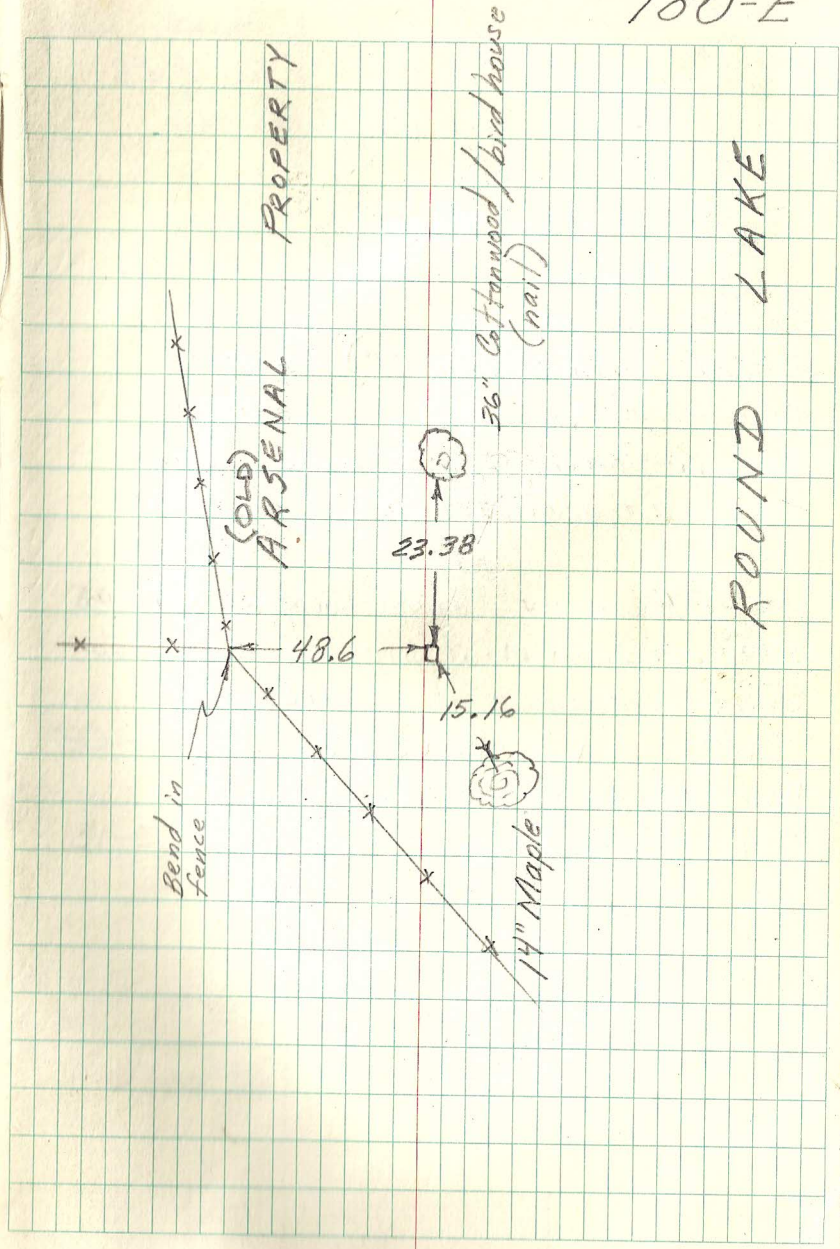
Found a granite monument, up +/- 0.3 ft; checked condition of tie 5-1-13