WEST 1/4 COR. SEC. 22-30-23

MONU. NO. 182
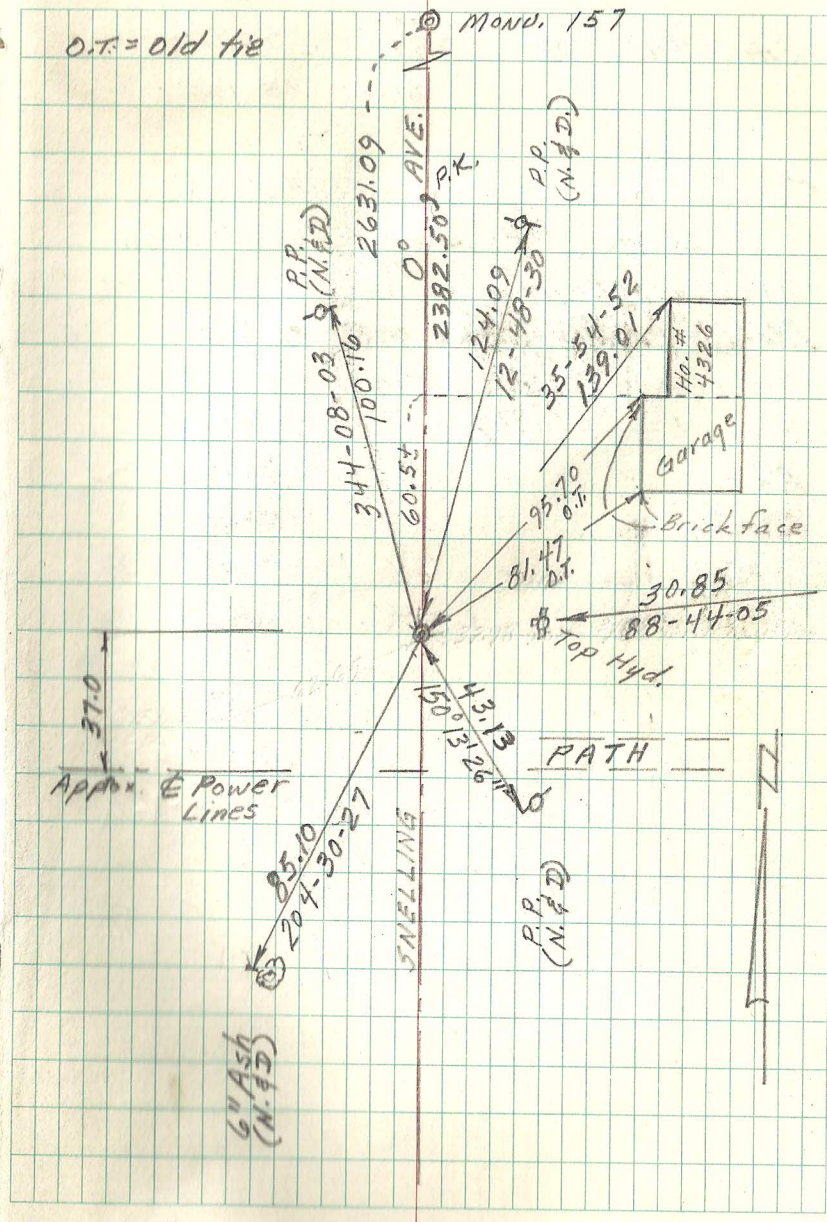
Found granite down 0.2 ft.
Placed cast iron cap and
bolt. Re-tied Sept. 10, 1974
Monu. tied; cap & bolt removed for
City road project. 7-31-91
Set 20" C.I.M.. 10-14-92
Retied monu.. 2-1-93
Retied monu. (flush). 8-6-03
Retied monument, Oct. 6TH, 2008
Found "Ramsey County" C.I.M. flush in bit.
road; checked condition of ties 4-22-13