N¼ Cor. Sec. 1-30-22

Monu. No. 24SP (24SC)

Found granite down 0.3 ft.. Placed Cast Iron cap and bolt. Tied out May, 1974.

Found granite flush; retied 12-28-92

Granite removed by re construction of road in 1993. Granite determined to be closing corner, not on line. Correct position computed and marked. Tied out correct monu location, set P.K's.. 7-27-94

Set 20" C.I.M. at corrected position; set of P.K.s for old position left in place. 10-94

Removed 20" C.I.M. and set "3rd Corr. Line" (20" C.I.) 2.31 ft S. of closing corner (granite loc.) 10-95

Short Ties Checked 6/2/98 J.E.D.S

Found P.K. at closing corner; set 1" pipe. 9-22-98

Retied Monument 6/14/2004

RETIED MONUMENT 10-28-09

24SP
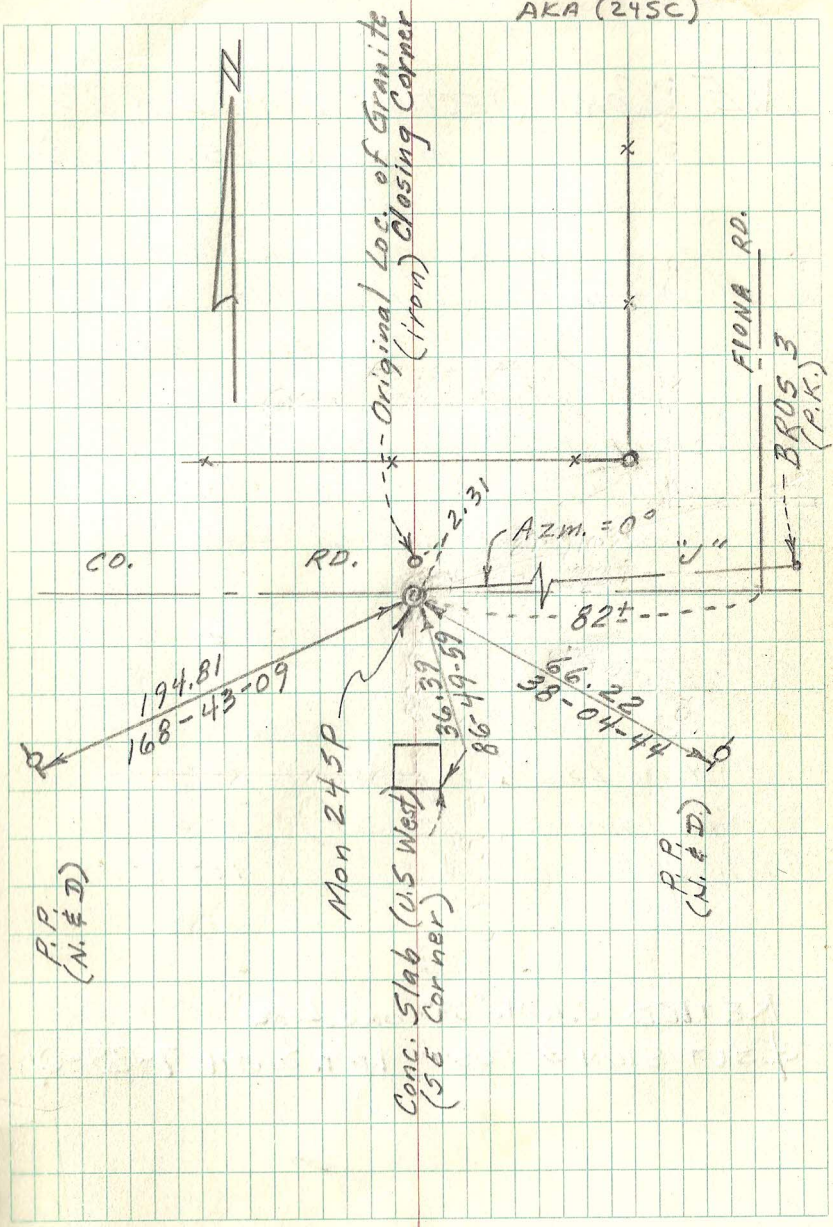
AKA (24SC)