E 1/4 Cor. Sec. 25-30-22

Monu. No. 250

Found 0.3 ft. rivit over granite monu.. Granite down 0.35 ft. May 28, 1974.
Set cast iron cap and bolt. 7-25-75
Re-tied Jan. 29, 1976
Retied monu. 6-21-91
Set 20" cast iron & cemented. 7-96
Retied. monu. 12-11-98
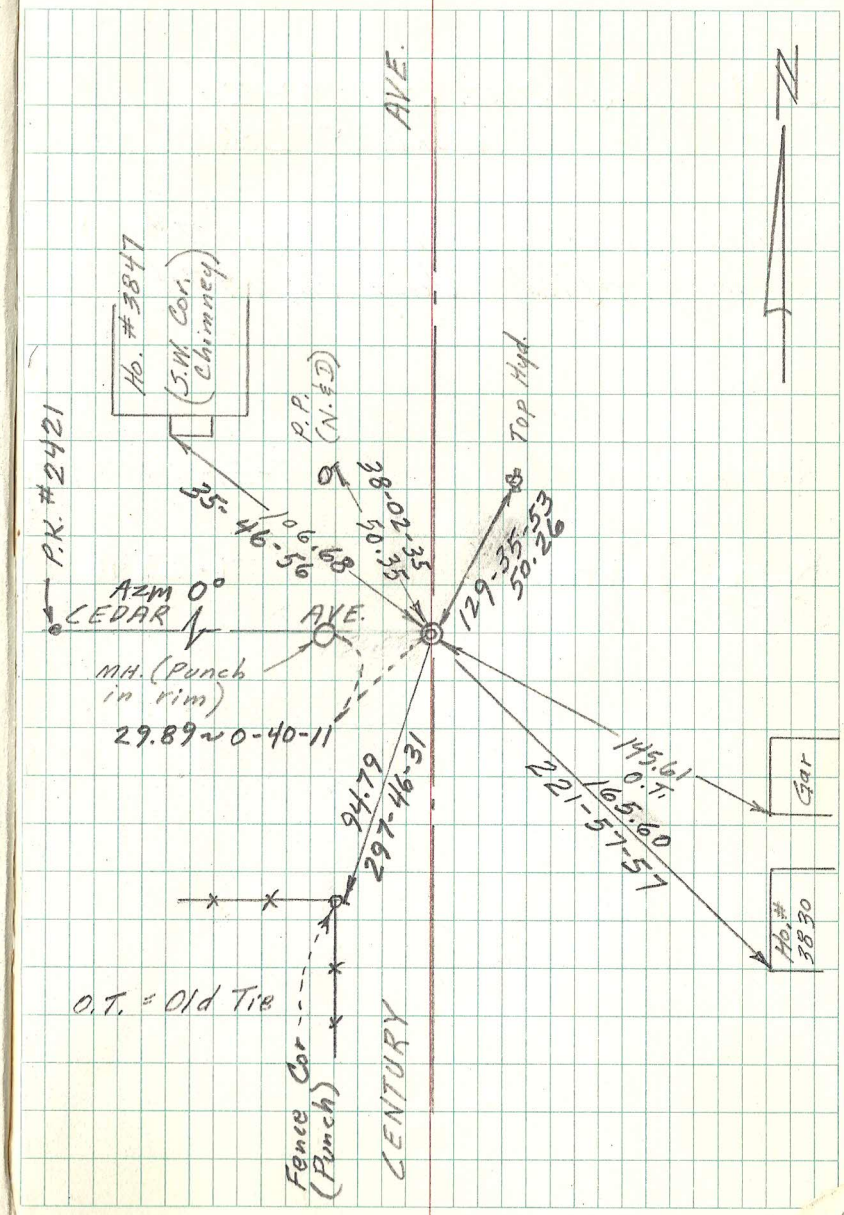
RETIED MONT. 7-28-05
Retied monu. 7-6-10