CENTER SEC. 31, T30, R22
MONU. No. 289
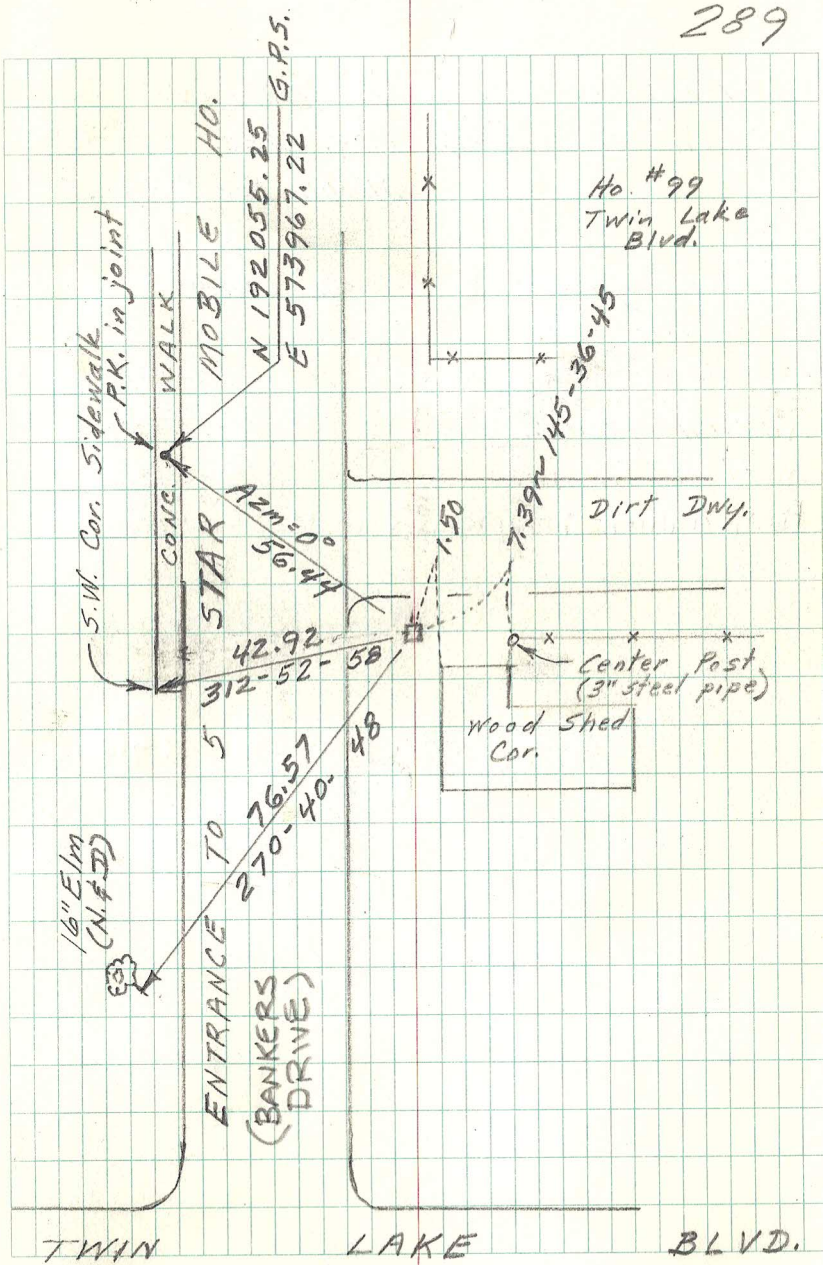
Found granite monu. 1975.
Retied monu.. 2-12-91.
Checked ties. 8-16-96
Retied granite. 8-19-03
Retied granite MON. 9-05-08
Found granite monument with drill hole, flush in ground; checked condition of ties 5-2-13